


If well telescopes please sketch and show depths.

GROUND LEVEL

4"
ALL
WAY

THIS WELL PRODUCED
175 GPM OPEN PIPE
500 GAL TANK
VERY NICE SETUP

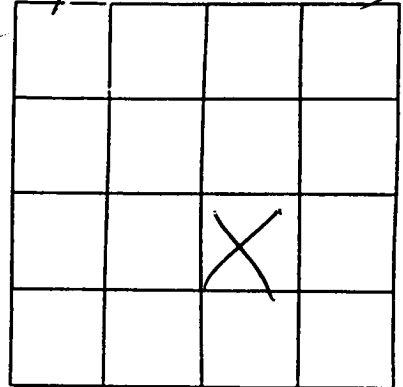

SECTION 14 M-51

Please indicate well location X.

Pump Capacity (GPM)	No. of Stages	Setting Depth
60	9	200 FT.

PUMP TEST

Well yielded 75 GPM with
a drawdown of 2X ft.
after 14 hours of pumping

LOG DATA

TYPE OF LOG RUN (Circle One): No Log Run, Electric, Gamma Ray, Density, Sonic, Neutron, Other (Describe) _____

Name of Organization Running Log _____

GEOLOGIC DATA (Office Use Only)

Surface Elev.	Geologic Unit	Unit Thickness	Depth to Top
Subs. SWL	Date	Analysis	Aquifer Test

Driller's Remarks

THIS WELL WAS A VERY
TOUGH WELL TO GET
THE CASING IN IT
TOOK 9 HRS TO GET 270'
CASING IN HOLE

If more than one screen,
show location of each on sketch.

BUT MAN WHAT A WELL!!!