STATE WELL REPORT

County: Pearl river Permit #: Driller: Scott Boone 09/27/2021 Date drilling completed:

Well Owner Information

(Landowner if borehole is not for a water well)

Part 1 Driller's Log

Mississippi Department of Environmental Quality Office of Land and Water Resources P.O. Box 2309 Jackson, MS 39225-2309 (601)961-5555

(601)961-5228 (fax)

For Office Use Only: Well #: <u>M67</u> Aquifer: E-Log #: _

Well or Borehole Location

State Law requires that this report be prepared by the license holder responsible for the work and filed with the Department at the above address within 30 days of completion of drilling of the well or borehole.

(Landowner if borehole is not for a water well)	Latitude: 30.7723790 Longitude: -89.4844730				
Owner Name: Charlie Colbert Progress rd	Method of Lat/Long (check one): Conventional Survey,				
Mailing Address: Progress rd	USGS quad, Hand-held GPS, Survey-grade GPS				
Poplarville Ms 39470					
Poplarville Ms 39470 City State Zip Code	4Miles Eof Poplarville				
Telephone No. ()					
	Borehole Data				
	rd: 09/27/2021 Hole depth: 260 Hole diameter: 7-1/4				
Location of the source of any surface water used for dri					
Method of dosing and volume of Chlorine used in drilling	and development: Granular				
	mma Ray Density Sonic Neutron Other:				
Name of organization running log(s):					
Purpose of borehole (check one): Water Well 🗹 Geotech	nnical/Geological Investigation Ground Source Heat Pump				
Seismic Survey Othe	er (describe)				
If drilling is not related to water well	construction, skip the remainder of this block				
Purpose of Well (check all applicable): Home Indust	rial Public Supply Irrigation Fish Culture				
Other (describe):					
If a flowing well, method of flow regulation: Valve	Other (describe)				
Static Water Level: 153feet [above or [below] land surface Date measured: 09/28/2021					
Method of measurement (check one): Steel tape ☐ Electr	ric tape Air line Other (<i>describe</i>):				
Well depth: 260 Well grouted to a depth of: 10	feet Type of grout (check one) Neat Cement Bentonite Mix				
Casing length: 240 feet Casing diameter: 4 inches Type of casing: PVC					
Screen length: 20 feet Screen diameter:	4inches Type of screen: PVC				
Screen slot size: 08 inches Setting dept	h: From 240 feet to 260 feet				
Type of completion (check all applicable): Gravel packed Underreamed Open hole Natural Development					
Other (describe):					
Top of lap pipe or reduction in casing:feet					
If telescoped or more than one screen, describe on next page					

Form: OLWR-SWR-1A (4/13)

County: Pearl river	10-0
Permit #:	By

RECEIVED
10-05-2021
BY OLWR

For Office Use Only:		
Well #:	M67	

The sketch below only required for water wells

If well telescopes, show depths on sketch.

Ground Level		
	•	


<u>Description of formations encountered must be provided for all wells</u> <u>and boreholes, unless specifically exempted by regulations</u>

Description of Formations Encountered	From (depth)	To (depth)
Sand	Ground level	6
Orange clay	6	8
Sand n gravel	8	63
Blue clay	63	210
Chorus sand	210	260
Still in sand when I stopped		

If more than one screen, show location of each on sketch

Sketch the property layout and include the following:

- 1) the well location
- 2) any permanent structures on the property that may aid in locating the well
- 3) any roads, power lines, or other items that may aid in locating the property and the well
- 4) north arrow

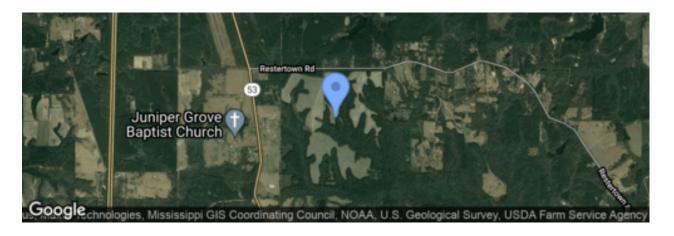

Landowner Name: Charlie Colbert

I HEREBY CERTIFY that the well/borehole was drilled, constructed, and completed in accordance with all applicable requirements of the Mississippi Department of Environmental Quality and the Mississippi Department of Health regulations, if applicable, and state laws.

Scott Boone 6262 10/01/2021 Scott Boone
Print Name of Responsible Licensee and License No. Date Signature of Licensee

Form: OLWR-SWR-1B (4/13)