STATE WELL REPORT					
County: Pearl river Permit #: Driller: Scott Boone Date drilling completed: 01/11/2022	Part 1 Driller's Log Mississippi Department of Environmental Quality Office of Land and Water Resources P.O. Box 2309		For Office Use Well #: Aquifer: E-Log #:		
(601)961-5555 elev 275 (601)961-5228 (fax) elev 275 State Law requires that this report be prepared by the license holder responsible for the work and filed with the Department at the above address within 30 days of completion of drilling of the well or borehole.					
Well Owner Informati         (Landowner if borehole is not for         Owner Name:       Charles Colbe         Mailing Address:       148 restertor         Poplarville       MS         City       State	a water well) rt wn rd <u>39470</u> Zip Code	Latitude: <u>30.7648730</u> Lon Method of Lat/Long ( <i>check one</i> USGS quad, Hand-held G <u>SE</u> 1/4 <u>SE</u> 1/4, Sec_	): Conventional Surve PS <u>V</u> , Survey-grade 22 T <u>03S</u> F	4800, gps, ₹15W	
Miles     Miles       Telephone No. (985)     630-1057       Well / Borehole Data					
Date drilling started:       01/10/2022       Date drilling completed:       01/11/2022       Hole depth:       260       Hole diameter:       7-1/4         Location of the source of any surface water used for drilling:       Pond         Method of dosing and volume of Chlorine used in drilling and development:       Granular         Logs run (check all applicable): No log run       Electric Gamma Ray Density Sonic Neutron Other:         Name of organization running log(s):					
Static Water Level: <u>151</u> feet Method of measurement (check one): S Well depth: <u>260</u> Well grouted to a Casing length: <u>240</u> feet Ca Screen length: <u>20</u> feet S Screen slot size: <u>.08</u> inches Type of completion (check all applicable Other (describe):	[ above or ⊵belo (check one) steel tape⊡Electric depth of: <u>10</u> f sing diameter: <u>4</u> creen diameter: <u>4</u> Setting depth: e): Gravel packed⊡	bw] land surface       Date measur         tape       Air line       Other (describe)         eet       Type of grout (check one)	ed: 01/11/202 ): Neat Cement Bento casing: PVC screen: PVC 0 260f Natural Developme	nite Mix	

County:	Pearl river
-	
Permit #:	



For Office Use Only:


Well #: \_\_\_\_\_\_M69

The sketch below only required for water wells

## If well telescopes, show depths on sketch.

×

Ground Level \_

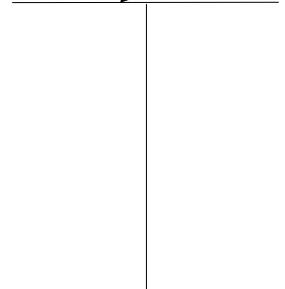


Description of formations encountered must be provided for all wells and boreholes, unless specifically exempted by regulations

Description of Formations Encountered	From (depth)	To (depth)
Sandy red clay	Ground level	7
Sand n gravel	7	55
Blue clay	55	198
Sand.	198	260
Still in it when I stopped		

If more than one screen, show location of each on sketch

Sketch the property layout and include the following:

- 1) the well location
- 2) any permanent structures on the property that may aid in locating the well
- 3) any roads, power lines, or other items that may aid in locating the property and the well
- 4) north arrow

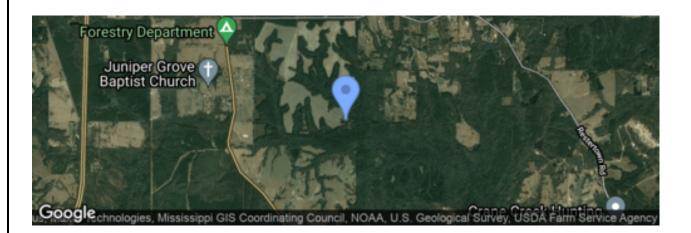

Landowner Name: Charles Colbert

I HEREBY CERTIFY that the well/borehole was drilled, constructed, and completed in accordance with all applicable requirements of the Mississippi Department of Environmental Quality and the Mississippi Department of Health regulations, if applicable, and state laws.

Scott Boone 6262 Print Name of Responsible Licensee and License No. 01/28/2022 Date



Scott Boone Signature of Licensee

Form: OLWR-SWR-1B (4/13)