

M 2000

12-22-61

WATER WELL DRILLERS LOG

Date: 12-22, 1961, Driller: SUTTER WELL WKS. County PEARL RIVER  
 (Name)

	Description & Color of Materials Sand, Clay, Red Clay, Shell, etc.	Thick- ness Feet	Depth Feet
(1) Owner of Land: <u>W.A. ALEXANDER</u> (Name) <u>PICAYUNE, MISS.</u> (Address)	<u>all sand</u>		
(2) Location: <u>CENTER</u> of <u>NE 1/4</u> , Sec. <u>21</u> T <u>35</u> R <u>15</u> S <u>W</u> <u>6</u> miles <u>SE</u> of <u>Poplarville</u> (distance) (direction) (Nearest Town)			
(3) Topography: <u>Hilly</u> (Hilly) (Flat) (Level)			
(4) Purpose of Well: <u>domestic</u> (Domestic Irrigation Municipal, Industrial, Other)			


Information upon completion of well:

- (1) Diameter 4 inches.
- (2) Total Depth 88 feet.
- (3) Water Level 17 feet below top of ground.
- (4) Cased to all, Size 4"
- (5) Screen: Size 4", Length 10'
- (6) Were any formations sealed against pollution?  
 \_\_\_\_\_ yes,  no.

If YES depth of formation \_\_\_\_\_

Why \_\_\_\_\_

Drillers Remarks: \_\_\_\_\_

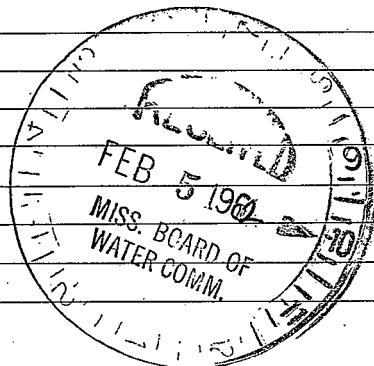

(Use Back Side)

Well No.

