

Pearl River
 M 2004
 4-26-76

MISSISSIPPI
 BOARD OF WATER COMMISSIONERS
 416 North State Street
 Jackson, Mississippi 39201

WATER WELL DRILLERS LOG

4-26-76^{13V} 19 Bud Penton & Son Pearl River
 date well completed firm name county well located

LANDOWNER: B.B. Smith
Opalville, Mo.
 (mailing address)

description of formations encountered	from	to
Red Shale	0	48
Red Sand	48	60
Blue Shale	60	200
Grey Sand	200	235

WELL LOCATION:
 sec. 8 T 3 N R. 15 E
1 miles S.E. of Opalville
 (distance) (direction) (nearest town)

WELL PURPOSE: None
 (home, irrigation, municipal, industrial)

WELL COMPLETION DATA:

- (1) diameter (inches) 4 in.
- (2) total depth (feet) 235
- (3) static water level (feet) 149 below top of ground.
- (4) casing PVC 2.25
 (material) (depth)
- _____ If telescope see back.
 (size)
- (5) screen 4 x 10, 225
 (length) (depth to top)
- m
 (size) (material)
- (6) pump 1 (HP) _____ (yield gpm)
electric
 (type power)
- (7) electric log No
 (yes or no)

(organization running log)

(8) how well bottom plugged
Bud Shank


DRILLERS REMARKS:

RECEIVED

SEP - 1 1975

If well telescopes please sketch and show depths.

GROUND LEVEL

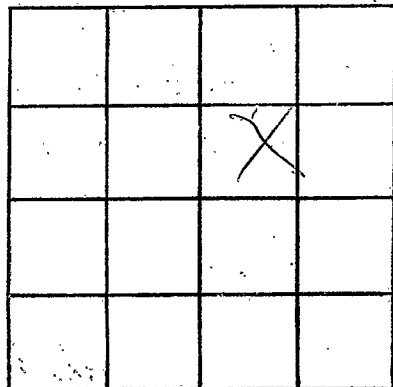

SECTION _____

Please indicate well location X.

ADDITIONAL INFORMATION

If more than one screen,
show locations of each on sketch.