

Pearl River
 M 2005,
 6-28-76

MISSISSIPPI
 BOARD OF WATER COMMISSIONERS
 416 North State Street
 Jackson, Mississippi 39201

WATER WELL DRILLERS LOG

6-28 1976 ¹³⁶ Herald Woodward Drilling P.R.
 date well completed firm name county well located

LANDOWNER: Don Murphy
Rt. 3 Box 180
Poplarville, Miss.
 (mailing address)

description of formations encountered	from	to
RED CLAY	3	15
FINE WHITE SAND	16	21

WELL LOCATION: ?
 sec. 36 T. 3 N. R. 15 E. S. 5 W.
9 miles SW of Poplarville
 (distance) (direction) (nearest town)


COARSE SAND	28	34
White CLAY	35	54

WELL PURPOSE: HOME
 (home, irrigation, municipal, industrial)

YELLOW SAND	55	60
-------------	----	----

- WELL COMPLETION DATA:
- diameter (inches) 2"
 - total depth (feet) 185'
 - static water level (feet) 177 below/above top of ground.
 - casing Plastic 180
 (material) (depth)
 (size) If telescope see back.
 - screen 6' 180'
 (length) (depth to top)
2" Plastic
 (size) (material)
 - pump 1/2 10
 (HP) (yield gpm)
115 AC
 (type power)
 - electric log No
 (yes or no)
SELF
 (organization running log)
 - how well bottom plugged 2" SS

Blue CLAY	64	123
COARSE SAND	127	170
WELL SET AT	135	

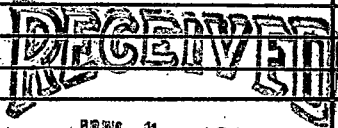


JUL 16 1976

DRILLERS REMARKS:

If well telescopes please sketch and show depths.

GROUND LEVEL

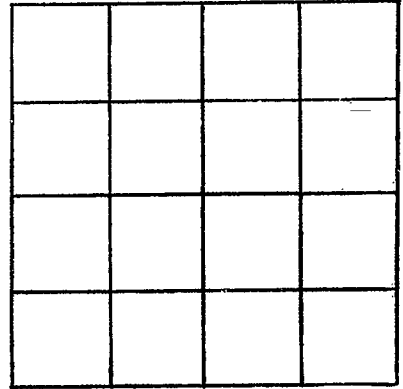

SECTION _____

Please indicate well location X.

ADDITIONAL INFORMATION

If more than one screen, show locations of each on sketch.