

Pearl River
M 2000
8/2/76

MISSISSIPPI
 BOARD OF WATER COMMISSIONERS
 416 North State Street
 Jackson, Mississippi 39201

WATER WELL DRILLERS LOG

8-2 1976 Pouncey Water Well Drilling PEARL RIVER ms.
 date well completed firm name county well located

LANDOWNER: JAMES L. LEWIS
Rt. 1, Progress community
Poplarville, Ms. 39466
 (mailing address)

WELL LOCATION:
 sec. 12 T 3 N R. 15
6 miles S-E of Poplarville
 (distance) (direction) (nearest town)

WELL PURPOSE: HOME
 (home, irrigation, municipal, industrial)

- WELL COMPLETION DATA:
- (1) diameter (inches) 2"
 - (2) total depth (feet) 192'
 - (3) static water level (feet) 120' below top of ground.
 - (4) casing Pvc 40-182'
 (material) (depth)
2" If telescope see back.
 (size)
 - (5) screen 10' 182'
 (length) (depth to top)
2' Pvc slot-wraps
 (size) (material)
 - (6) pump 1/2 HP 5
 (HP) (yield gpm)
220 Volts. AC
 (type power)
 - (7) electric log
 (yes or no)
 (organization running log)
 - (8) how well bottom plugged sealed
No slit-sd-etc.


description of formations encountered	from	to
Top Soil	0	4
CLAY	4	8
Sd-Rocks	8	12
clay-Big Rocks	12	32
white clay	32	64
Blue clay	64	80
Sd-slt. O	80	86
Blue silt	86	96
Blue-Large silt streaks	96	130
Sd-	130	134
Blue. Bge.	134	150
lime silt	150	176
hard to Rocks	176	192

RECEIVED
 SEP 15 1976

DRILLERS REMARKS: SCREEN
set in pvc ground and
ROCKS.

If well telescopes please sketch and show depths.

GROUND LEVEL

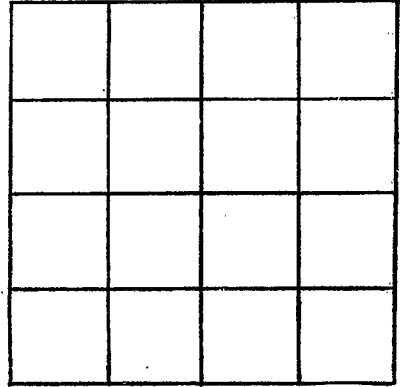

SECTION _____

Please indicate well location X.

ADDITIONAL INFORMATION

A series of horizontal lines providing space for additional information.

If more than one screen, show locations of each on sketch.