

Pearl River  
M 2007  
1-7-77

MISSISSIPPI  
 BOARD OF WATER COMMISSIONERS  
 416 North State Street  
 Jackson, Mississippi 39201

WATER WELL DRILLERS LOG

1-7 1977 Bud Anton Pearl River  
 date well completed firm name county well located

LANDOWNER:  
Gary Roth  
Poplarville, Miss.  
 (mailing address)

description of formations encountered	from	to
<u>white shale</u>	<u>0</u>	<u>85</u>
<u>white sand</u>	<u>85</u>	<u>130</u>
<u>gray shale</u>	<u>130</u>	<u>155</u>
<u>gray sand red</u>	<u>155</u>	<u>180</u>

WELL LOCATION:  
 sec. 26 T. 3 N R. 14 E  
6 1/2 miles S-E of Poplarville  
 (distance) (direction) (nearest town)

WELL PURPOSE: Home  
 (home, irrigation, municipal, industrial)

- WELL COMPLETION DATA:
- (1) diameter (inches) 4 in
  - (2) total depth (feet) 180
  - (3) static water level (feet) 68 below above top of ground.
  - (4) casing PVC 170  
 (material) (depth)  
 \_\_\_\_\_ if telescope see back.  
 (size)
  - (5) screen 10 170  
 (length) (depth to top)  
4 in PVC  
 (size) (material)
  - (6) pump 1 660 m  
 (HP) (yield gpm)  
electric  
 (type power)
  - (7) electric log NO  
 (yes or no)
  - \_\_\_\_\_ (organization running log)
  - (8) how well bottom plugged sand shack


DRILLERS REMARKS:

**RECEIVED**  
 APR 15 1977

MISS. BD. OF WATER COMM.

If well telescopes please sketch and show depths.

GROUND LEVEL

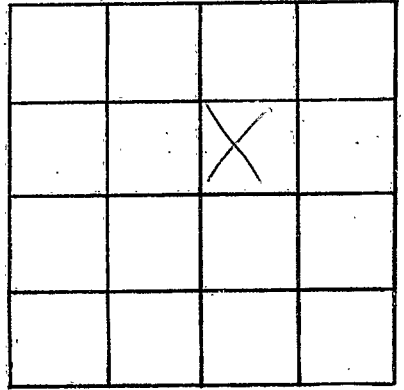

SECTION \_\_\_\_\_

Please indicate well location X.

ADDITIONAL INFORMATION

If more than one screen, show locations of each on sketch.