

Paul R  
M 2008  
7/11/77

MISSISSIPPI  
BOARD OF WATER COMMISSIONERS  
416 North State Street  
Jackson, Mississippi 39201

WATER WELL DRILLERS LOG

7-1 1977 Bud Porter & Son Paul River  
date well completed firm name county well located

LANDOWNER:  
Benny Lumpkins  
Doyleville, Ms.  
(mailing address)

description of formations encountered	from	to
<u>Red Shale</u>	<u>0</u>	<u>10</u>
<u>sand &amp; Rock</u>	<u>10</u>	<u>22</u>
<u>white shale</u>	<u>22</u>	<u>78</u>
<u>white sand</u>	<u>98</u>	<u>133</u>

WELL LOCATION:  
sec. 2 T. 3 N. R. 15 E  
7 miles E of Doyleville  
(distance) (direction) (nearest town)

WELL PURPOSE: Home  
(home, irrigation, municipal, industrial)

WELL COMPLETION DATA:

(1) diameter (inches) 2

(2) total depth (feet) 132

(3) static water level (feet) 47 <sup>below</sup> <sub>above</sub> top of ground.

(4) casing PVC, 117  
(material) (depth)

(size) If telescope see back.

(5) screen 2x5, 117  
(length) (depth to top)

12, PVC  
(size) (material)

(6) pump 1 450  
(HP) (yield gpm)

electric 7.59<sup>m</sup>  
(type power)

(7) electric log no  
(yes or no)

(organization running log)

(8) how well bottom plugged  
Sand Shale

DRILLERS REMARKS:


RECEIVED  
RISER

DEC 30 1977

MISS. BD. OF WATER COMM.

If well telescopes please sketch and show depths.

GROUND LEVEL

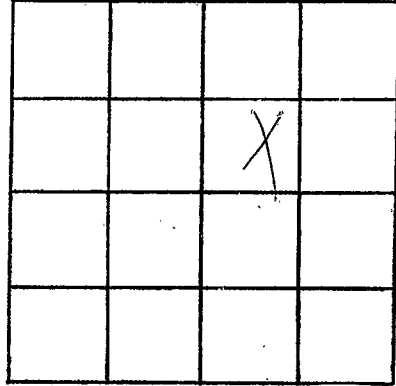

SECTION \_\_\_\_\_

Please indicate well location X.

ADDITIONAL INFORMATION

If more than one screen,  
show locations of each on sketch.