

Pearl River
M 2009
10-12-77

MISSISSIPPI
 BOARD OF WATER COMMISSIONERS
 416 North State Street
 Jackson, Mississippi 39201

WATER WELL DRILLERS LOG

10-12- 1977 Jackobell Bros Inc Pearl River
 date well completed firm name county well located

LANDOWNER:
Mrs. Maxine Johnson
Poplarville, Miss.
 (mailing address)

description of formations encountered	from	to
Clay	0	18
Sand	18	30
Clay	30	85
Sand	85	120

WELL LOCATION:
 sec. 30 T. 3 N. R. 16 E
4 miles E of Deerby
 (distance) (direction) (nearest town)

WELL PURPOSE: Home
 (home, irrigation, municipal, industrial)


- WELL COMPLETION DATA:
- (1) diameter (inches) 2"
 - (2) total depth (feet) 120'
 - (3) static water level (feet) 60' below top of ground.
 - (4) casing P.V.C., 115'
 (material) (depth)
2" if telescope see back.
 (size)
 - (5) screen 5, 115'
 (length) (depth to top)
2", P.V.C.
 (size) (material)
 - (6) pump 1 h.p., 18
 (HP) (yield gpm)
E. Lee
 (type power)
 - (7) electric log No.
 (yes or no)
No.
 (organization running log)
 - (8) how well bottom plugged Sand Shale

RECEIVED
 OCT 25 1977

DRILLERS REMARKS:

If well telescopes please sketch and show depths.

GROUND LEVEL

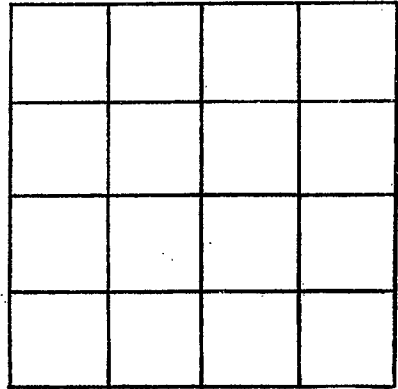

SECTION _____

Please indicate well location X.

ADDITIONAL INFORMATION

If more than one screen, show locations of each on sketch.