

PEARL RIVER

M 2011

MISSISSIPPI BOARD OF WATER COMMISSIONERS
416 North State Street
Jackson, Mississippi 39201

WATER WELL DRILLERS LOG

June 18, 1978 date well completed
178 Dixie Water Well Pump, Inc. firm name
Pearl River county well located

LANDOWNER: <u>Holiday Flying Service</u> <u>Poplarville, Ms.</u> (mailing address)	description of formations encountered	from	to
	Red Sand	0	20
	Brown Sand & Gravel	20	58
	Clay (White)	58	170
	Blue Clay	170	205
	Coarse White Sand	205	239

WELL LOCATION:

sec. 16 T 3 N R 15 E
S W
2 miles east of Poplarville
(distance) (direction) (nearest town)

WELL PURPOSE: Industrial
(home, irrigation, municipal, industrial)

WELL COMPLETION DATA:

- (1) diameter (inches) 4"
- (2) total depth (feet) 239'
- (3) static water level (feet) 165 below top of ground.
- (4) casing P.V.C. 229'
(material) (depth)
4" if telescope see back.
(size)
- (5) screen 10' 229'
(length) (depth to top)
4" P.V.C.
(size) (material)
- (6) pump 1/2 300 gph
(HP) (yield gpm)
Electric
(type power)
- (7) electric log No
(yes or no)

(organization running log)

(8) how well bottom plugged
Sand Shank


DRILLERS REMARKS:

RECEIVED
JUL - 5 1978

MISS. BD. OF WATER COMM

If well telescopes please sketch and show depths.

GROUND LEVEL

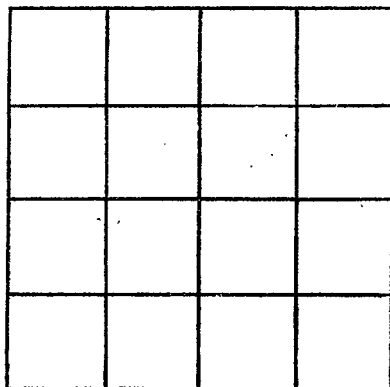

SECTION _____

Please indicate well location X.

ADDITIONAL INFORMATION

If more than one screen,
show locations of each on sketch.