

PEARL RIVER

M 2012

9-1-78

MISSISSIPPI BOARD OF WATER COMMISSIONERS
416 North State Street
Jackson, Mississippi 39201

WATER WELL DRILLERS LOG

9/1 1978 Budgenton & Son Pearl River
date well completed firm name county well located

LANDOWNER: M William Longnecker
Popperwell Miss
(mailing address)

description of formations encountered	from	to
<u>Gray shale</u>	<u>0</u>	<u>80</u>
<u>clay sand</u>	<u>80</u>	<u>135</u>

WELL LOCATION:
sec. 3 T. 3 N R. 15 E
2 miles E of Millard Miss
(distance) (direction) (nearest town)

WELL PURPOSE: home
(home, irrigation, municipal, industrial)

- WELL COMPLETION DATA:
- (1) diameter (inches) 2"
 - (2) total depth (feet) 135
 - (3) static water level (feet) 63 below top of ground.
 - (4) casing PVC 125'
(material) (depth)
30 if telescope see back.
(size)
 - (5) screen 10" 125'
(length) (depth to top)
12 PVC
(size) (material)
 - (6) pump 1 550
(HP) (yield gpm)
Elect
(type power)
 - (7) electric log no
(yes or no)

(organization running log)
(8) how well bottom plugged plugged


DRILLERS REMARKS:

RECEIVED
OCT 4 1978

MISS. BD. OF WATER COMMISSIONERS

If well telescopes please sketch and show depths.

GROUND LEVEL

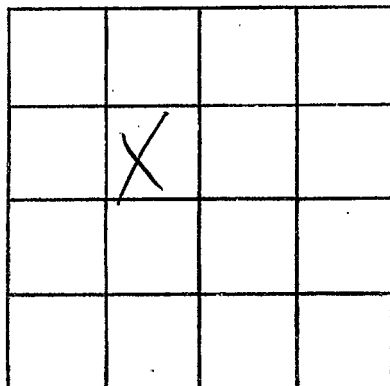

SECTION _____

Please indicate well location X.

ADDITIONAL INFORMATION

If more than one screen,
show locations of each on sketch.