

Pearl River  
 M 2014  
 May 21, 1979

MISSISSIPPI  
 BOARD OF WATER COMMISSIONERS  
 416 North State Street  
 Jackson, Mississippi 39201

WATER WELL DRILLERS LOG  
 TOM GRIFFITH

May 21 1979  
 date well completed

PLUMBING & WELL SERVICE, INC.  
 320 MARSHALL AVE.  
 COLUMBIA, MS 39429

Pearl River  
 county well located

LANDOWNER: Ronald B. Stephens  
 Rt. 2 Box 85 - Poplarville (mailing address)  
 WELL LOCATION: sec. 9 T. 3 N. R. 15 E. 3 miles (distance) S (direction) Poplarville (nearest town)  
 WELL PURPOSE: (home, irrigation, municipal, industrial)

description of formations encountered	from	to
Top Soil	0	2
Clay	2	7
Sand	7	9
Shale	9	10
Shale	10	18
Sand	18	20

WELL COMPLETION DATA:

(1) diameter (inches) 2 1/2"  
 (2) total depth (feet) 240 ft  
 (3) static water level (feet) 20 ft below top of ground.  
 (4) casing plastic, 220 ft (material) (depth)  
 2" (size) if telescope see back.  
 (5) screen 20 ft, 220 ft (length) (depth to top)  
 2" (size) plastic (material)  
 (6) pump 12 gals (HP) (yield gpm)  
 Electric (type power)  
 (7) electric log no (yes or no)  
 (organization running log)  
 (8) how well bottom plugged Back Wash Valve

Miss. Board of Water Comm.


JUL 9 1979

RECEIVED

DRILLERS REMARKS:

If well telescopes please sketch and show depths.

GROUND LEVEL

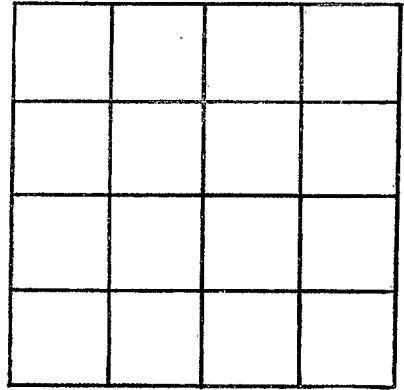

SECTION \_\_\_\_\_

Please indicate well location X.

ADDITIONAL INFORMATION

If more than one screen, show locations of each on sketch.