

PEARL RIVER

M 2015

8-24-79

MISSISSIPPI  
 BOARD OF WATER COMMISSIONERS  
 416 North State Street  
 Jackson, Mississippi 39201

WATER WELL DRILLERS LOG

8-24 1979 Braden Pump Pearl River  
 date well completed firm name county well located  
 Well Ser. Inc.

LANDOWNER: R.W. Burge

RE. 4, Box 484

Poplarville, MS

(mailing address)

WELL LOCATION:

sec. 9 T. 3 R. 15  
 S W  
 2 miles SE of Poplarville  
 (distance) (direction) (nearest town)

WELL PURPOSE: HOME  
 (home, irrigation, municipal, industrial)

WELL COMPLETION DATA:

- (1) diameter (inches) 2"
- (2) total depth (feet) 280'
- (3) static water level (feet) 155' below above top of ground.
- (4) casing PVC total  
 (material) (depth)  
 2" (size) if telescope see back.
- (5) screen 10' 270'  
 (length) (depth to top)  
 2" (size) corr PVC under bar (material)
- (6) pump 1/2 4  
 (HP) (yield gpm)  
 220V 1φ (type power)
- (7) electric log NO  
 (yes or no)

(organization running log)

(8) how well bottom plugged 2" sand pack

DRILLERS REMARKS:

no tail pipe

description of formations encountered

from to

clay	0	180
sand + clay	180	200
sand	200	280


Miss. Board of Water Comm.

SEP - 4 1979

RECEIVED

If well telescopes please sketch and show depths.

GROUND LEVEL

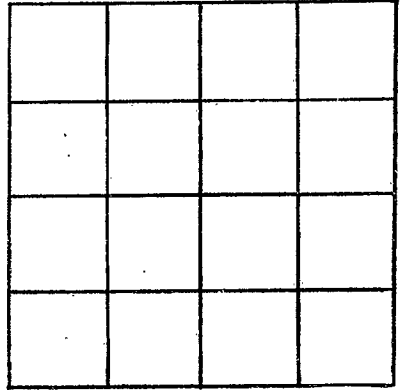

SECTION \_\_\_\_\_

Please indicate well location X.

ADDITIONAL INFORMATION

If more than one screen, show locations of each on sketch.