

Pearl River
Miss

MISSISSIPPI
BOARD OF WATER COMMISSIONERS
416 North State Street
Jackson, Mississippi 39201

WATER WELL DRILLERS LOG

10-6-79

October 6, 1979 date well completed Rejoice Water Well & Pump, Inc. firm name Pearl River county well located

LANDOWNER: <u>Charles Mairon</u>	description of formations encountered	from	to
<u>Mitairie La.</u>			
(mailing address)	<u>Red Sand</u>	<u>0</u>	<u>33</u>
WELL LOCATION: sec. <u>28</u> T <u>3</u> N R <u>15</u> E <u>3</u> miles <u>South</u> of <u>Poplarville</u> (distance) (direction) (nearest town)	<u>White Clay</u>	<u>33</u>	<u>150</u>
WELL PURPOSE: <u>Home</u> (home, irrigation, municipal, industrial)	<u>Blue Clay</u>	<u>150</u>	<u>208</u>
WELL COMPLETION DATA: (1) diameter (inches) <u>4"</u>	<u>Gray Sand</u>	<u>208</u>	<u>254</u>
(2) total depth (feet) <u>254'</u>			
(3) static water level (feet) <u>140</u> <u>below</u> top of ground.			
(4) casing <u>P.V.C.</u> , <u>234</u> (material) (depth) <u>4"</u> If telescope see back. (size)			
(5) screen <u>20'</u> , <u>254'</u> (length) (depth to top) <u>4"</u> , <u>P.V.C.</u> (size) (material)			
(6) pump <u>1</u> , <u>20</u> (HP) (yield gpm) <u>Electric</u> (type power)			
(7) electric log <u>No</u> (yes or no)			
(organization running log)			
(8) how well bottom plugged <u>Good Hard</u>			
DRILLERS REMARKS:			


DEPT. OF NATURAL RESOURCES
BUREAU OF LAND & WATER RESOURCES

NOV - 5 1979

RECEIVED

If well telescopes please sketch and show depths.

GROUND LEVEL

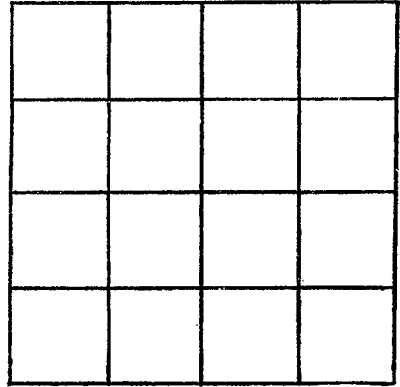

SECTION _____

Please indicate well location X.

ADDITIONAL INFORMATION

If more than one screen,
show locations of each on sketch.