

MISSISSIPPI
 BOARD OF WATER COMMISSIONERS
 416 North State Street
 Jackson, Mississippi 39201

WATER WELL DRILLERS LOG

Pearl Ri.
M 2017
11-7-79

11-7 1979 Bearden Pump Well Pearl River
 date well completed firm name county well located

Service, Inc

LANDOWNER: Mary Gibson
A. 3 Box 463-E
Poplarville, MS 39470
 (mailing address)

description of formations encountered	from	to
	<u>Clay</u> <u>Sand</u>	<u>0</u> <u>86</u>

WELL LOCATION:
 sec 34 T 3 N R 15 E
5 miles N of Savannah
 (distance) (direction) (nearest town)

WELL PURPOSE: Home
 (home, irrigation, municipal, industrial)

WELL COMPLETION DATA:

- (1) diameter (inches) 2"
 - (2) total depth (feet) 85'
 - (3) static water level (feet) 39 below top of ground.
 - (4) casing PC (material) total (depth)
2" (size) If telescope see back.
 - (5) screen 5' (length) 34' (depth to top)
2" (size) 100% PVC underbar (material)
 - (6) pump 1 (HP) 10 (yield gpm)
220 1/2 (type power)
 - (7) electric log NO (yes or no)
- (organization running log)

(8) how well bottom plugged 2 sand shank

DRILLERS REMARKS:
no tail pipe


DEPT. OF NATURAL RESOURCES
 BUREAU OF LAND & WATER RESOURCES

JAN 14 1980

RECEIVED

If well telescopes please sketch and show depths.

GROUND LEVEL

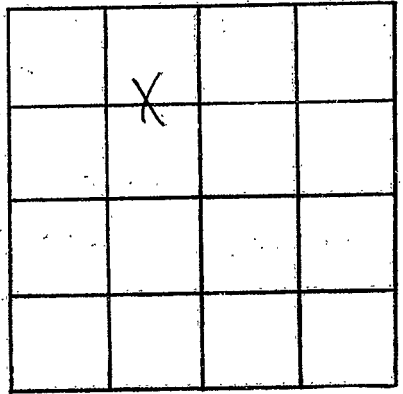

SECTION 34

Please indicate well location X.

ADDITIONAL INFORMATION

If more than one screen, show locations of each on sketch.