

Pearl River  
 M 207  
 8-28-80

MISSISSIPPI  
 BOARD OF WATER COMMISSIONERS  
 416 North State Street  
 Jackson, Mississippi 39201

WATER WELL DRILLERS LOG

8-28-1980 date well completed  
 Farness Anderson Pearl River firm name  
 county well located

LANDOWNER: John E. Book

description of formations encountered from to

Paplarville, Ms  
 (mailing address)

top soil 0 2

WELL LOCATION:

sec 13 T 3 N R 15 E  
 4 miles SE of Paplarville  
 (distance) (direction) (nearest town)

clay 2 24

WELL PURPOSE: home  
 (home, irrigation, municipal, industrial)

Fine sand 24 38

WELL COMPLETION DATA:

- (1) diameter (inches) 2"
- (2) total depth (feet) 190'
- (3) static water level (feet) 68' below top of ground.
- (4) casing Plastic, 40'  
 (material) (depth)

Clay 38 160

if telescope see back.  
 (size)

Fine sand 160 176

- (5) screen 5' 40'  
 (length) (depth to top)

Coarse sand 176 190

(size) (material)

- (6) pump 1/8  
 (HP) (yield gpm)

DEPT. OF NATURAL RESOURCES  
 BUREAU OF LAND & WATER RESOURCES

Electric  
 (type power)

- (7) electric log NO  
 (yes or no)

OCT 14 1980

(organization running log)


RECEIVED

- (8) how well bottom plugged Capped

DRILLERS REMARKS:

If well telescopes please sketch and show depths.

GROUND LEVEL

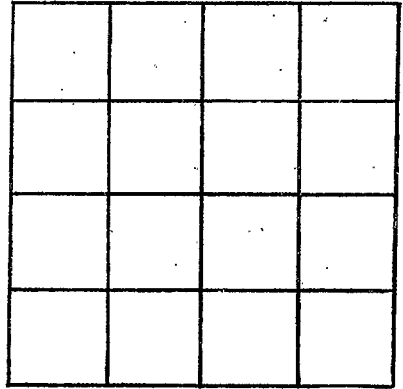

SECTION \_\_\_\_\_

Please indicate well location X.

ADDITIONAL INFORMATION

If more than one screen, show locations of each on sketch.