

MISSISSIPPI DEPARTMENT OF NATURAL RESOURCES

Bureau of Land and Water Resources

Southport Mall

P.O. Box 10631

Jackson, Mississippi 39209

WATER WELL DRILLERS LOG

Pearl River
M 2020
11-19-81

Nov 19 1981 Walker Welding Pearl River
 date well completed firm name county well located
Repair Shop

LANDOWNER: <u>W. F. Townsend</u>	description of formations encountered	from	to
<u>R 4 Box 442</u>	<u>Red shaly</u>	<u>0</u>	<u>16</u>
<u>poplarville Miss</u> (mailing address)	<u>Red sand</u>	<u>16</u>	<u>18</u>
WELL LOCATION:	<u>White shaly</u>	<u>18</u>	<u>65</u>
sec. <u>34</u> T. <u>3</u> N. R. <u>15</u> E.	<u>Coarse sand</u>	<u>65</u>	<u>110</u>
S. <u>5</u> miles S. <u>5</u> <u>poplarville</u> (distance) (direction) (nearest town)	<u>lingual</u>		
WELL PURPOSE: <u>Reservoir</u> (home, irrigation, municipal, industrial)			
WELL COMPLETION DATA:			
(1) diameter (inches) <u>2"</u>			
(2) total depth (feet) <u>110'</u>			
(3) static water level (feet) <u>54</u> below top of ground.			
(4) casing <u>PVC</u> , <u>100</u> (material) (depth)			
(size) If telescope see back.			
(5) screen <u>10'</u> , <u>100</u> (length) (depth to top)			
<u>12</u> , <u>PVC</u> (size) (material)			
(6) pump <u>1</u> , <u>6</u> (HP) (yield gpm)			
<u>Electric</u> (type power)			
(7) electric log (yes or no) _____			
(organization running log) _____			
(8) how well bottom plugged <u>sand</u> <u>spack</u>			
DRILLERS REMARKS: _____			


DEPT OF NATURAL RESOURCES
 BUREAU OF LAND & WATER RESOURCES

NOV 23 1981

RECEIVED

If well telescopes please
sketch and show depths.

GROUND LEVEL

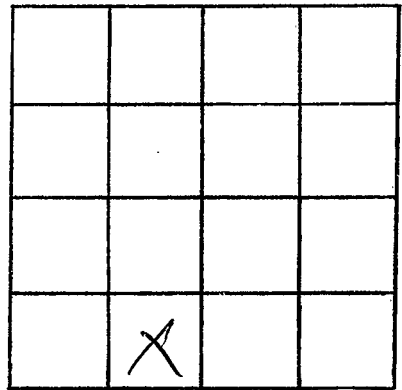

SECTION _____

Please indicate well location X.

ADDITIONAL INFORMATION

If more than one screen,
show locations of each on sketch.