

MISSISSIPPI DEPARTMENT OF NATURAL RESOURCES

Bureau of Land and Water Resources

Southport Mall

P.O. Box 10631

Jackson, Mississippi 39209

WATER WELL DRILLERS LOG

Pearl River
M 2022

Feb 14 19 19
date well completed

Bud Penton & Son
firm name

PEARL RIVER
county well located

LANDOWNER: Mr. Bush
Rt 4, Poplarville MS
(mailing address)

description of formations encountered	from	to
<u>white shale</u>	<u>0</u>	<u>23</u>
<u>Blue shale</u>	<u>23</u>	<u>140</u>
<u>white sand</u>	<u>140</u>	<u>165</u>
<u>Blue sand</u>	<u>165</u>	<u>240</u>
<u>gray sand</u>	<u>240</u>	<u>311</u>

WELL LOCATION:
sec. 32 T. 3 N R. 15 E
S W
12 miles SE of Poplarville
(distance) (direction) (nearest town)

WELL PURPOSE: Home
(home, irrigation, municipal, industrial)

- WELL COMPLETION DATA:
- (1) diameter (inches) 4"
 - (2) total depth (feet) 311
 - (3) static water level (feet) 150 below above-top of ground.
 - (4) casing PVC 311'
(material) (depth)
 - 4x2 if telescope see back.
(size)
 - (5) screen 16' 300'
(length) (depth to top)
 - 2" PVC
(size) (material)
 - (6) pump 3/4 900
(HP) (yield gpm)
 - Elect.
(type power)
 - (7) electric log (yes or no) _____
(organization running log) _____

(8) how well bottom plugged Sand
Shale

DRILLERS REMARKS: _____

DEPT. OF NATURAL RESOURCES
BUREAU OF LAND & WATER RESOURCES

MAR 26 1992

RECEIVED


If well telescopes please sketch and show depths.

GROUND LEVEL

113'

198'

10'

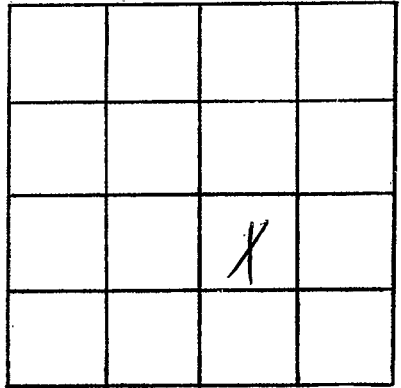

SECTION _____

Please indicate well location X.

ADDITIONAL INFORMATION

If more than one screen, show locations of each on sketch.