

MISSISSIPPI DEPARTMENT OF NATURAL RESOURCES

Bureau of Land and Water Resources

Southport Mall

P.O. Box 10631

Jackson, Mississippi 39209

WATER WELL DRILLERS LOG

Pearl River
M
2023

APPR 10-20 1982 BRADEN Pump & Well Service Pearl River
 date well completed firm name county well located

| LANDOWNER: | description of formations encountered | from | to |
|--|---------------------------------------|------|-----|
| AN-FARA FARMS CT. 2, Box 82 POPLARVILLE (mailing address) | | SAND | 0 |
| WELL LOCATION: sec. <u>4</u> T. <u>3</u> R. <u>15</u> S W N E <u>2</u> miles <u>SE</u> of <u>Poplarville</u> (distance) (direction) (nearest town) | Red GRAVEL | 10 | 60 |
| WELL PURPOSE: <u>HOME</u> (home, irrigation, municipal, industrial) | GRAVEL | 60 | 70 |
| WELL COMPLETION DATA: | WHITE CLAY | 70 | 200 |
| (1) diameter (inches) <u>4"</u> | SAND | 200 | 210 |
| (2) total depth (feet) <u>320</u> | CLAY | 210 | 240 |
| (3) static water level (feet) <u>185</u> below top of ground. | BLUE CLAY | 240 | 260 |
| (4) casing <u>PVC</u> , <u>310'</u> (material) (depth) | SAND | 260 | 320 |
| (size) if telescope see back. | | | |
| (5) screen <u>10'</u> , <u>310</u> (length) (depth to top) | | | |
| <u>4"</u> , <u>PVC Underbar</u> (size) (material) | | | |
| (6) pump <u>3HP (15 STAGE)</u> (HP) (yield gpm) | | | |
| <u>220V</u> (type power) | | | |
| (7) electric log <u>No</u> (yes or no) | | | |
| (organization running log) | | | |
| (8) how well bottom plugged. <u>2" Rodman Valve</u> | | | |

DEPT. OF NATURAL RESOURCES
 BUREAU OF LAND & WATER RESOURCES


JAN 13 1983

RECEIVED

DRILLERS REMARKS:

If well telescopes please sketch and show depths.

GROUND LEVEL

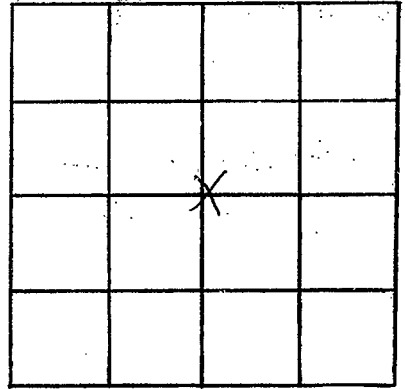

SECTION 4

Please indicate well location X.

ADDITIONAL INFORMATION

If more than one screen,
show locations of each on sketch.