

MISSISSIPPI DEPARTMENT OF NATURAL RESOURCES

Bureau of Land and Water Resources

Southport Mall

P.O. Box 10631

Jackson, Mississippi 39209

WATER WELL DRILLERS LOG

Paul Rivers
M
2024

3-1-83 19
 date well completed

Walker Welling
 firm name

Paul River
 county well located

LANDOWNER: C.W. Stewart
Picayune Miss
 (mailing address)

WELL LOCATION:
 sec. 11 T 3 N R 15 E
5 miles South Jacksonville
 (distance) (direction) (nearest town)

WELL PURPOSE: Home
 (home, irrigation, municipal, industrial)

- WELL COMPLETION DATA:
- (1) diameter (inches) 4"
 - (2) total depth (feet) 230
 - (3) static water level (feet) 72 below top of ground.
 - (4) casing pvc, 230
 (material) (depth)
 (size) if telescope see back.
 - (5) screen 10", 220'
 (length) (depth to top)
12, pvc
 (size) (material)
 - (6) pump 1/2, 8
 (HP) (yield gpm)
Electric
 (type power)
 - (7) electric log (yes or no) _____
 (organization running log) _____
 - (8) how well bottom plugged Sand
Sharp

description of formations encountered	from	to
<u>Grey shale</u>	<u>0</u>	<u>72</u>
<u>fine sand</u>	<u>72</u>	<u>80</u>
<u>Grey shale</u>	<u>80</u>	<u>124</u>
<u>fine sand</u>	<u>124</u>	<u>138</u>
<u>Grey shale</u>	<u>138</u>	<u>195</u>
<u>Sand fine gravel</u>	<u>195</u>	<u>230</u>

DEPT. OF NATURAL RESOURCES
 BUREAU OF LAND & WATER RESOURCES


APR 4 1983

RECEIVED

DRILLERS REMARKS: _____

If well telescopes please sketch and show depths.

GROUND LEVEL

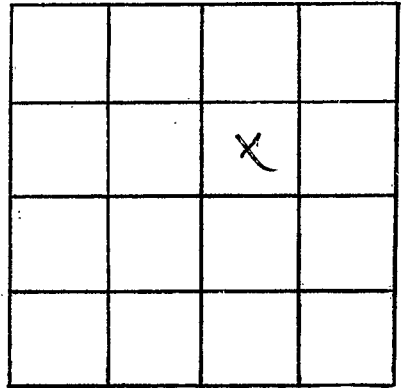

SECTION _____

Please indicate well location X.

ADDITIONAL INFORMATION

If more than one screen,
show locations of each on sketch.