

MISSISSIPPI DEPARTMENT OF NATURAL RESOURCES

BUD PENTON Bureau of Land and Water Resources
 WATER WELL SERVICE Southport Mall
 ROUTE 1 BOX 10631
 CARRIERS, MS 39209 P.O. Box 10631
 PHONE 783-5324 Jackson, Mississippi 39209

14

Paul River
 M
 2025

WATER WELL DRILLERS LOG

BUD PENTON & SON
 WATER WELL SERVICE
 ROUTE 1 BOX 10631
 CARRIERS, MS 39209
 PHONE 783-5324

Paul River
 county well located

7/12 1983
 days well completed

LANDOWNER: *Jack Regan*

description of formations encountered

from to

B.T. 2 Poplarville Miss

*Red shale
 Red sand*

*0 21
 21 63*

(mailing address)

WELL LOCATION:

sec. 16 T. 3 N R. 15 E
 S W
6 miles E of Poplarville
 (distance) (direction) (nearest town)

WELL PURPOSE: home
 (home, irrigation, municipal, industrial)

WELL COMPLETION DATA:

- (1) diameter (inches) 4"
- (2) total depth (feet) 63'
- (3) static water level (feet) 41 below above top of ground.
- (4) casing pvc 63'
 (material) (depth)
 _____ if telescope see back.
 (size)
- (5) screen 10 53
 (length) (depth to top)
12 pvc
 (size) (material)
- (6) pump 1/2 800
 (HP) (yield gpm)
Electric
 (type power)
- (7) electric log no
 (yes or no)

(organization running log)

(8) how well bottom plugged hard
shark

DRILLERS REMARKS:


DEPT. OF NATURAL RESOURCES
 BUREAU OF LAND & WATER RESOURCES

NOV 18 1983

RECEIVED

If well telescopes please sketch and show depths.

GROUND LEVEL

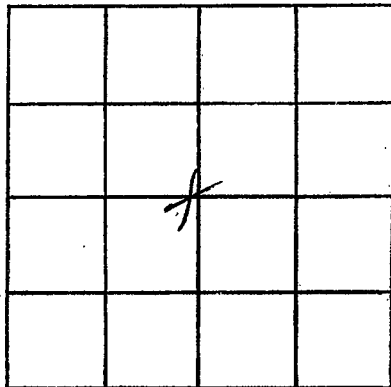

SECTION _____

Please indicate well location X.

ADDITIONAL INFORMATION

If more than one screen,
show locations of each on sketch.