

MISSISSIPPI DEPARTMENT OF NATURAL RESOURCES

Bureau of Land and Water Resources

Southport Mall

P.O. Box 10631

Jackson, Mississippi 39209

WATER WELL DRILLERS LOG

PEARL RIVER  
M 2027  
6/28/85

6-28-85

POUNCEY WATER WELL DRILLING Pool River

date well completed

firm name

county well located

LANDOWNER

Johnny Hagan  
Wes Smith Rd.

description of formations encountered

from

to

(mailing address)

WELL LOCATION:

sec. 32 T 15 N R 15 E S 15  
4 miles E of Pearl River  
(distance) (direction) (nearest town)

TOP  
Silt. sd granite 0 21  
COSS 41 116  
Sd 116 270

WELL PURPOSE:

(home, irrigation, municipal, industrial)

WELL COMPLETION DATA:

- (1) diameter (inches) 4
- (2) total depth (feet) 272
- (3) static water level (feet) 108 below above top of ground.
- (4) casing 4 262 (material) (depth)
- 4 if telescope see back. (size)
- (5) screen 10 262 (length) (depth to top)
- 4 PVC (size) (material)
- (6) pump 1 20 (HP) (yield gpm)
- HC (type power)
- (7) electric log (yes or no)

(organization running log)

(8) how well bottom plugged

Sealed

DRILLERS REMARKS:


RECEIVED

SEP 9 1985

Department of Natural Resources  
Bureau of Land & Water Resources

If well telescopes please sketch and show depths.

GROUND LEVEL

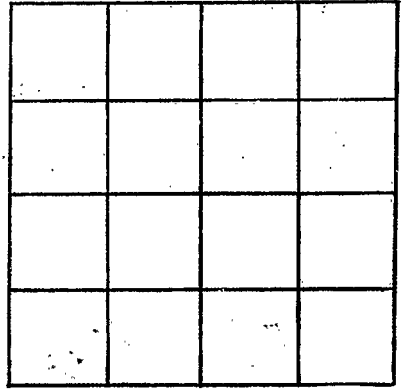

SECTION \_\_\_\_\_

Please indicate well location X.

ADDITIONAL INFORMATION

Lined area for additional information.

If more than one screen, show locations of each on sketch.