

MISSISSIPPI DEPARTMENT OF NATURAL RESOURCES

Bureau of Land and Water Resources

Southport Mall

P.O. Box 10631

Jackson, Mississippi 39209

WATER WELL DRILLERS LOG

PEARL RIVER

M 2028

6/29/85

6-29-85

POUNCEY WATER WELL DRILLING Pearl River

date well completed

firm name

county well located

LANDOWNER: Mr. Massey

Wes Smith Rd.

(mailing address)

WELL LOCATION:

sec 33 T 5 N R 3 E
 4 miles E of Denbo
 (distance) (direction) (nearest town)

WELL PURPOSE: Home
 (home, irrigation, municipal, industrial)

WELL COMPLETION DATA:

- (1) diameter (inches) 2
- (2) total depth (feet) 70
- (3) static water level (feet) 56 below top of ground
- (4) casing PVC 10 (material) (depth)
 2 (size) if telescope see back.
- (5) screen 10 40 (length) (depth to top)
 2 PVC (size) (material)
- (6) pump 1 8 (HP) (yield gpm)
 DC (type power)
- (7) electric log (yes or no)
- (organization running log)
- (8) how well bottom plugged Sealed

description of formations encountered

from

to


Top.	0	8
Clay	8	28
Silt.	28	38
Clay	38	46
Sand	46	70

DRILLERS REMARKS:

RECEIVED
 SEP 9 1985
 Department of Natural Resources
 Bureau of Land & Water Resources

If well telescopes please sketch and show depths.

GROUND LEVEL

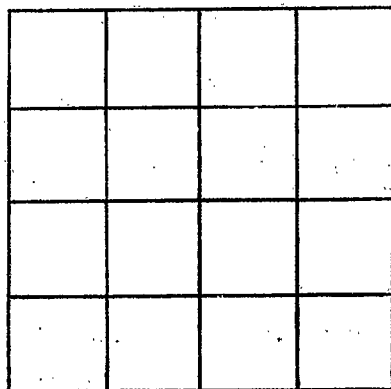

SECTION _____

Please indicate well location X.

ADDITIONAL INFORMATION

If more than one screen, show locations of each on sketch.