

MISSISSIPPI DEPARTMENT OF NATURAL RESOURCES

Bureau of Land and Water Resources

Southport Mall

P.O. Box 10631

Jackson, Mississippi 39209

WATER WELL DRILLERS LOG

PEARL RIVER
M 20029

Oct 3

date well completed

Clear Water Drilling

firm name

Pearl River

county well located

LANDOWNER: Tim PA JR
Poplarville Ms
39470
(mailing address)

description of formations encountered	from	to
TOP Soil	0	10"
Clay Tan	10"	25'
tan Sand	30	34'
yellow clay	34	80'
Blue Clay	180	180
Tan conc Sand	180	210

WELL LOCATION:
sec. 20 T 3 N R. 15 E W
2 miles SE of Poplarville
(distance) (direction) (nearest town)

WELL PURPOSE:
(home, irrigation, municipal, industrial)

WELL COMPLETION DATA:

(1) diameter (inches) 4"

(2) total depth (feet) 210'

(3) static water level (feet) 190' below above top of ground.

(4) casing PVC 200'
(material) (depth)

(size) if telescope see back.

(5) screen 10' 200'
(length) (depth to top)

200' PVC S6T
(size) (material)

(6) pump 1/2 12
(HP) (yield gpm)

220
(type power)

(7) electric log _____
(yes or no)

(organization running log)

(8) how well bottom plugged SS

RECEIVED


NOV 21 1996

Department of Natural Resources
Bureau of Land & Water Resources

DRILLERS REMARKS:

If well telescopes please
sketch and show depths.

GROUND LEVEL

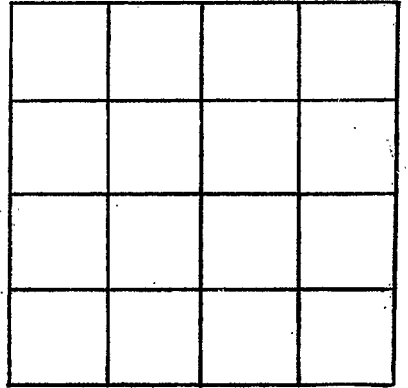

SECTION _____

Please indicate well location X.

ADDITIONAL INFORMATION

If more than one screen,
show locations of each on sketch.