

MISSISSIPPI DEPARTMENT OF NATURAL RESOURCES

Bureau of Land and Water Resources

Southport Mall

P.O. Box 10631

Jackson, Mississippi 39209

WATER WELL DRILLERS LOG

P RIVER  
M 2032  
1

10/13 1988 Bed Reston Pearl River  
date well completed firm name county well located

LANDOWNER: Don Roberts  
Reston Road  
Poplarville Miss.  
(mailing address)

description of formations encountered	from	to
<u>Red shale</u>	<u>0</u>	<u>35</u>
<u>Red sand</u>	<u>35</u>	<u>85</u>

WELL LOCATION:  
sec. 15 T. 3 N R. 15 E  
S W  
4 miles East of Poplarville  
(distance) (direction) (nearest town)

WELL PURPOSE: home  
(home, irrigation, municipal, industrial)

WELL COMPLETION DATA:

(1) diameter (inches) 2

(2) total depth (feet) 85

(3) static water level (feet) 20 below above top of ground.

(4) casing pvc, 85  
(material) (depth)  
(size) if telescope see back.

(5) screen 10, 75  
(length) (depth to top)  
1/2, pvc  
(size) (material)

(6) pump no  
(HP) (yield gpm)  
(type power)

(7) electric log no  
(yes or no)  
(organization running log)

(8) how well bottom plugged Shale


RECEIVED  
NOV 15 1988

Department of Natural Resources  
Bureau of Land & Water Resources

DRILLERS REMARKS: no  
Pump furnished

If well telescopes please sketch and show depths.

GROUND LEVEL

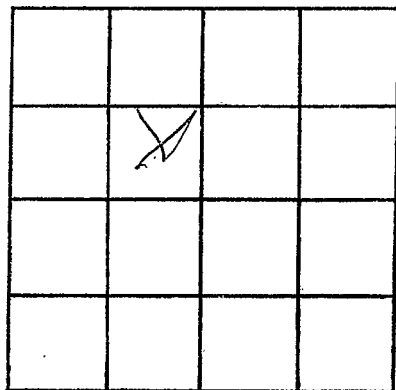

SECTION 15

Please indicate well location X.

ADDITIONAL INFORMATION

If more than one screen,  
show locations of each on sketch.