

MISSISSIPPI DEPARTMENT OF NATURAL RESOURCES

Bureau of Land and Water Resources

Southport Mall

P.O. Box 10631

Jackson, Mississippi 39209

WATER WELL DRILLERS LOG

P. River  
M 2033

10/153 1988 Bud Benton Pearl River  
date well completed firm name county well located

LANDOWNER: Don Roberts  
Besty Road  
Paplar Mill ms  
(mailing address)

description of formations encountered	from	to
<u>Red shell</u>	<u>0</u>	<u>31</u>
<u>Red sand</u>	<u>31</u>	<u>85</u>

WELL LOCATION:  
sec. 15 T 3 N R 15 E  
S W  
4 miles East of Paplar Mill  
(distance) (direction) (nearest town)

WELL PURPOSE: none  
(home, irrigation, municipal, industrial)

- WELL COMPLETION DATA:
- (1) diameter (inches) 1 1/2"
  - (2) total depth (feet) 85
  - (3) static water level (feet) 40 below above top of ground.
  - (4) casing PVC 85  
(material) (depth)
  - (5) screen 10 75  
(length) (depth to top)
  - (6) pump no PVC  
(HP) (yield gpm)
  - (7) electric log no  
(yes or no)
  - (8) how well bottom plugged hard  
stone

DRILLERS REMARKS:




NOV 15 1988

Department of Natural Resources  
Bureau of Land & Water Resources

If well telescopes please sketch and show depths.

GROUND LEVEL

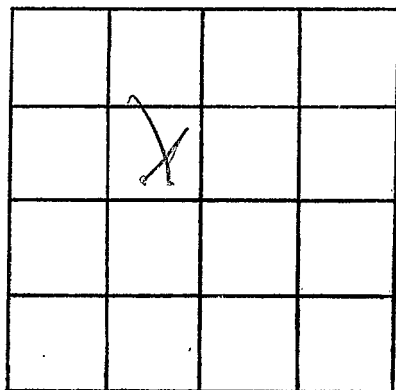

SECTION 15

Please indicate well location X.

ADDITIONAL INFORMATION

If more than one screen,  
show locations of each on sketch.