

MISSISSIPPI DEPARTMENT OF NATURAL RESOURCES

Bureau of Land and Water Resources

Southport Mall

P.O. Box 10631

Jackson, Mississippi 39209

WATER WELL DRILLERS LOG

P. River  
M 2034

10/16 date well completed      1988 Budgeton firm name      Pearl River county well located


LANDOWNER: Don Roberts  
Boster Road  
Joplinville  
(mailing address)

description of formations encountered	from	to
<u>Red shale</u>	<u>0</u>	<u>32</u>
<u>Red sand</u>	<u>32</u>	<u>86</u>

WELL LOCATION:  
sec. 15 T. 3 N R. 15 E  
S W  
1/4 miles East of Joplinville  
(distance) (direction) (nearest town)

WELL PURPOSE: home  
(home, irrigation, municipal, industrial)

- WELL COMPLETION DATA:
- (1) diameter (inches) 2 1/2"
  - (2) total depth (feet) 86
  - (3) static water level (feet) 40 below above top of ground.
  - (4) casing pvc, 86  
(material) (depth)
  - (size) if telescope see back.
  - (5) screen 10, 76  
(length) (depth to top)
  - 1/2, pvc  
(size) (material)
  - (6) pump 1, 450  
(HP) (yield gpm)
  - Elect  
(type power)
  - (7) electric log no  
(yes or no)

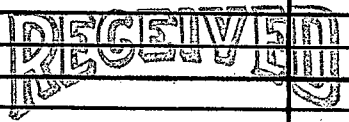

NOV 15 1988

(organization running log)


Department of Natural Resources  
Bureau of Land & Water Resources

(8) how well bottom plugged land  
short

DRILLERS REMARKS:

If well telescopes please sketch and show depths.

GROUND LEVEL

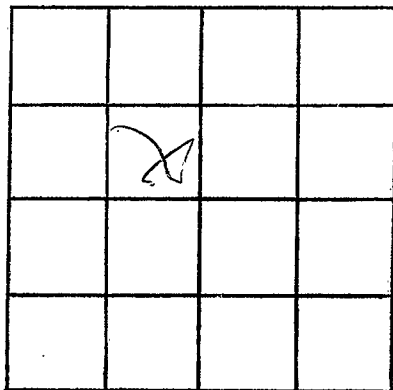

SECTION 15

Please indicate well location X.

ADDITIONAL INFORMATION

If more than one screen,  
show locations of each on sketch.