

MISSISSIPPI DEPARTMENT OF NATURAL RESOURCES

Bureau of Land and Water Resources

Southport Mall

P.O. Box 10631

Jackson, Mississippi 39209

WATER WELL DRILLERS LOG

P. RIVER
M 2037

1/4 1987 Clear Water Drilling Co. Pearl River
date well completed firm name county well located

LANDOWNER: Tommy Smith
Hwy 93
Fordo Creek Poplarville, MS
(mailing address) 39970

WELL LOCATION:
sec. 33 T 3 N R 15 E
(S) (W)
10 miles E of Poplarville
(distance) (direction) (nearest town)

WELL PURPOSE: None
(home, irrigation, municipal, industrial)

WELL COMPLETION DATA:

- (1) diameter (inches) 4
- (2) total depth (feet) 250
- (3) static water level (feet) 130 below top of ground.
- (4) casing PVC 290 (material) (depth) if telescope see back.
- (5) screen 10' 290' (length) (depth to top)
4" 200 PVC slot (size) (material)
- (6) pump 2 12 (HP) (yield gpm)
220 (type power)
- (7) electric log (yes or no)
(organization running log)
- (8) how well bottom plugged 55

| description of formations encountered | from | to |
|---------------------------------------|------|-----|
| Top Soil | 0 | 2" |
| Small clay mix | 2' | 10' |
| Red-yellow clay | 10 | 30' |
| light blue clay | 30 | 95' |
| Grey clay | 30 | 95 |
| light blue clay | 95 | 225 |
| med + coarse SP. Sand | 225 | 230 |
| Fine SP. Sand | 230 | 237 |
| med + Fine tan Sand | 237 | 250 |


RECEIVED
FEB 10 1989

Department of Natural Resources
Bureau of Land & Water Resources

DRILLERS REMARKS:

If well telescopes please
sketch and show depths.

GROUND LEVEL

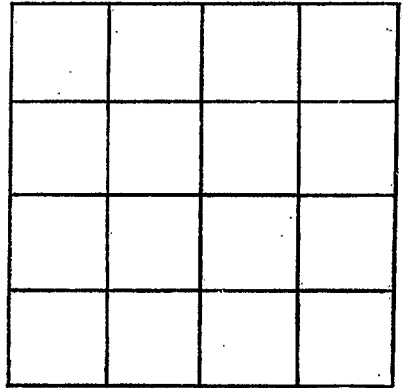

SECTION _____

Please indicate well location X.

ADDITIONAL INFORMATION

If more than one screen,
show locations of each on sketch.