

MISSISSIPPI DEPARTMENT OF NATURAL RESOURCES

Bureau of Land and Water Resources

Southport Mall

P.O. Box 10631

Jackson, Mississippi 39209

WATER WELL DRILLERS LOG

Pi River
M 2038

April 3 1988 Clear Water Drilling Inc. Pearl River
 date well completed firm name county well located

LANDOWNER: Wuell Hitt
Rt 3 Box 862
Poplarville Ms. 39470
 (mailing address)


description of formations encountered	from	to
Top Soil	0	4"
Red + yellow clay	4"	30'
red fine tan sand	30	80'
Blue clay	80	190
med. coarse sand	190	220

WELL LOCATION:
 sec. 5 T 3 N R 15 E
 (S) (W)
 miles town of Poplarville
 (distance) (direction) (nearest town)

WELL PURPOSE: Home
 (home, irrigation, municipal, industrial)

- WELL COMPLETION DATA:
- (1) diameter (inches) 4
 - (2) total depth (feet) 220'
 - (3) static water level (feet) 112 below above top of ground.
 - (4) casing Pvc 200
 (material) (depth)
 (size) if telescope see back.
 - (5) screen 20' 200
 (length) (depth to top)
6/12 Pvc 5/17
 (size) (material)
 - (6) pump 1 1/2 25
 (HP) (yield gpm)
220V AC
 (type power)
 - (7) electric log (yes or no)
 (organization running log)
 - (8) how well bottom plugged SS

DRILLERS REMARKS:

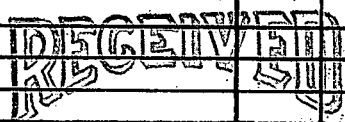


FEB 10 1989

Department of Natural Resources
 Bureau of Land & Water Resources

If well telescopes please
sketch and show depths.

GROUND LEVEL

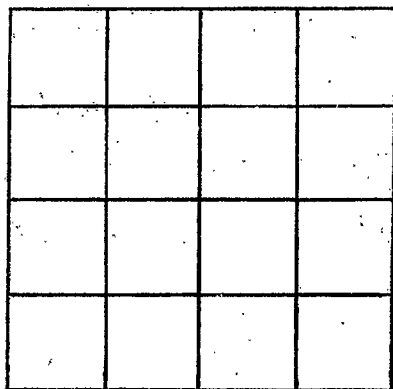

SECTION _____

Please indicate well location X.

ADDITIONAL INFORMATION

If more than one screen,
show locations of each on sketch.