

MISSISSIPPI DEPARTMENT OF NATURAL RESOURCES

Bureau of Land and Water Resources

Southport Mall

P.O. Box 10631

Jackson, Mississippi 39209

WATER WELL DRILLERS LOG

P. R. Rouse
M 2041


6/12 1989 date well completed Bud Pentecoston firm name Pearl River county well located

LANDOWNER: <u>Bonnie Smith</u>	description of formations encountered	from	to
<u>1208 S River Street</u>	<u>Red Shale</u>	<u>0</u>	<u>12</u>
<u>Rayburn Miss.</u>	<u>Red Sand</u>	<u>12</u>	<u>38</u>
(mailing address)	<u>Blue Shale</u>	<u>38</u>	<u>90</u>
	<u>White Sand</u>	<u>90</u>	<u>105</u>
	<u>Blue Shale</u>	<u>105</u>	<u>220</u>
	<u>White Sand</u>	<u>220</u>	<u>300</u>

WELL LOCATION:
sec. 6 T 3 N R. 15 E
S W
4 miles South of Rayburn
(distance) (direction) (nearest town)

WELL PURPOSE: none
(home, irrigation, municipal, industrial)

- WELL COMPLETION DATA:
- (1) diameter (inches) 4"
 - (2) total depth (feet) 300
 - (3) static water level (feet) 132 below above top of ground.
 - (4) casing pvc, 300
(material) (depth)
 - 4x2 if telescope see back.
(size)
 - (5) screen 15', 285'
(length) (depth to top)
 - 12
(size) pvc
(material)
 - (6) pump 1/2, 950
(HP) (yield gpm)
 - Elect
(type power)
 - (7) electric log no
(yes or no)

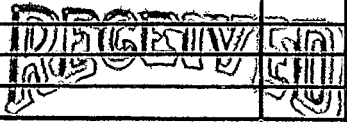

JAN 26 1990

MISSISSIPPI DEPARTMENT OF NATURAL RESOURCES
Bureau of Land and Water Resources


(organization running log)

(8) how well bottom plugged no

DRILLERS REMARKS:

If well telescopes please sketch and show depths.

GROUND LEVEL

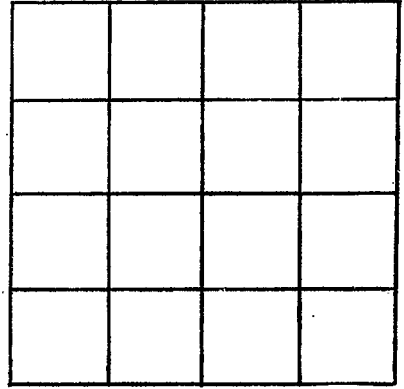

SECTION _____

Please indicate well location X.

ADDITIONAL INFORMATION

[Faint, illegible text, possibly a stamp or bleed-through]

If more than one screen, show locations of each on sketch.