

MISSISSIPPI DEPARTMENT OF NATURAL RESOURCES

Bureau of Land and Water Resources

Southport Mall

P.O. Box 10631

Jackson, Mississippi 39209

WATER WELL DRILLERS LOG

P. R. Welch
M 2042

9/22/89 19 Bed Reston & Son Pearl River
date well completed firm name county well located


LANDOWNER: Bernard Jones
R.T. 14 Box 5-11 Poplarville
Miss (mailing address)

description of formations encountered	from	to
Red shale	0	60
White sand	60	100
Blue shale	100	200
Gray sand	200	273

WELL LOCATION:
sec. 6 T. 3 N. R. 15 E
S W
4 miles South Poplarville
(distance) (direction) (nearest town)

WELL PURPOSE: home
(home, irrigation, municipal, industrial)

- WELL COMPLETION DATA:
- (1) diameter (inches) 4
 - (2) total depth (feet) 273
 - (3) static water level (feet) 142 below above top of ground.
 - (4) casing pvc, 273
(material) (depth)
 - 4 1/2 if telescope see back.
(size)
 - (5) screen 10, 263
(length) (depth to top)
 - 1 1/2, pvc
(size) (material)
 - (6) pump 1, 650
(HP) (yield gpm)
 - Elect
(type power)
 - (7) electric log no
(yes or no)

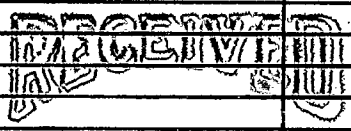

Department of Natural Resources
Bureau of Land and Water Resources

(organization running log)
(8) how well bottom plugged Shale

DRILLERS REMARKS:

If well telescopes please sketch and show depths.

GROUND LEVEL

		X	

SECTION _____

Please indicate well location X.

ADDITIONAL INFORMATION

[Faint, illegible text or sketch]

If more than one screen,
show locations of each on sketch.