

P. River
M 2043

MISSISSIPPI DEPARTMENT OF NATURAL RESOURCES
 Bureau of Land and Water Resources
 Southport Mall
 P.O. Box 10631
 Jackson, Mississippi 39209
WATER WELL DRILLERS LOG

10/1-90 1990 Bud Penton Pearl River
 date well completed firm name county well located

LANDOWNER: John Bennett description of formations encountered from to
RT 1 Box 707 Red shale 0 20
John Bennett Red sand 20 63
 (mailing address)

WELL LOCATION:
 sec. 15 T. 3 N R. 15 E
 S W
5 miles NE of Oshtobey
 (distance) (direction) (nearest town)

WELL PURPOSE: home
 (home, irrigation, municipal, industrial)

- WELL COMPLETION DATA:
- (1) diameter (inches) 2
 - (2) total depth (feet) 63
 - (3) static water level (feet) 24 below above top of ground.
 - (4) casing pvc, 6.3
 (material) (depth)
 (size) if telescope see back.
 - (5) screen 5, 3-8
 (length) (depth to top)
12, pvc
 (size) (material)
 - (6) pump 1, 172
 (HP) (yield gpm)
Elect
 (type power)
 - (7) electric log no
 (yes or no)
 (organization running log)
 - (8) how well bottom plugged part


RECEIVED
 OCT 15 1990

Department of Natural Resources
 Bureau of Land & Water Resources

DRILLERS REMARKS:

If well telescopes please sketch and show depths.

GROUND LEVEL

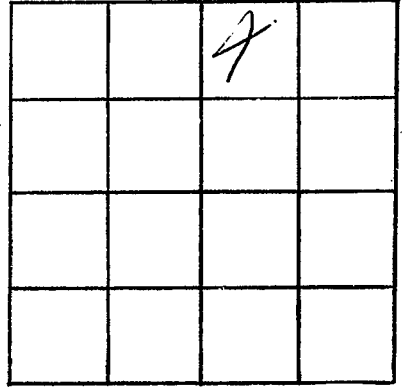

SECTION _____

Please indicate well location X.

ADDITIONAL INFORMATION

If more than one screen,
show locations of each on sketch.