

MISSISSIPPI DEPARTMENT OF NATURAL RESOURCES

Bureau of Land and Water Resources

Southport Mall

P.O. Box 10631

Jackson, Mississippi 39209

WATER WELL DRILLERS LOG

P. River
M 2045

12/10 1990 Bad Penton Pearl River
date well completed firm name county well located

LANDOWNER: Phillip
90 Bad Penton
Miss. (mailing address)

| description of formations encountered | from | to |
|---------------------------------------|------|-----|
| white shale | 0 | 20 |
| Red sand | 20 | 30 |
| Blue shale | 30 | 210 |
| Grey sand | 210 | 312 |

WELL LOCATION:
sec 20 T 3 N R 15 E
S W
2 miles East of Poplarville

WELL PURPOSE: home
(home, irrigation, municipal, industrial)

- WELL COMPLETION DATA:
- (1) diameter (inches) 4
 - (2) total depth (feet) 312
 - (3) static water level (feet) _____ below/above top of ground.
 - (4) casing PVC 312
(material) (depth)
 - (size) If telescope see back.
 - (5) screen 20 292
(length) (depth to top)
 - (size) 12 PVC (material)
 - (6) pump 5 90
(HP) (yield gpm)
 - Elect (type power)
 - (7) electric log NO
(yes or no)
 - (organization running log)
 - (8) how well bottom plugged


RECEIVED
FEB 19 1991

Dept. of Environmental Quality
Bureau of Land & Water Resources

DRILLERS REMARKS:

If well telescopes please sketch and show depths.

GROUND LEVEL

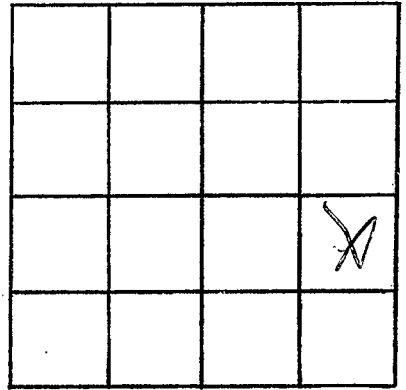

SECTION _____

Please indicate well location X.

ADDITIONAL INFORMATION

If more than one screen,
show locations of each on sketch.