

MISSISSIPPI DEPARTMENT OF NATURAL RESOURCES

Bureau of Land and Water Resources

Southport Mall

P.O. Box 10631

Jackson, Mississippi 39209

WATER WELL DRILLERS LOG

P. RIVER
M 2044

9/22
date well completed

1990 Bud Penton
firm name

Pearl River
county well located

LANDOWNER: Gee Farrell
Paplarville Miss.
Reston Rd 201
(mailing address)


description of formations encountered	from	to
<u>Red shale</u>	<u>0</u>	<u>30</u>
<u>Red sand</u>	<u>30</u>	<u>60</u>
<u>Blue shale</u>	<u>60</u>	<u>105</u>
<u>white sand</u>	<u>105</u>	<u>153</u>

WELL LOCATION:
sec. 24 T. 3 N. R. 15 E
8 miles East of Paplarville
(distance) (direction) (nearest town)

WELL PURPOSE: home
(home, irrigation, municipal, industrial)

WELL COMPLETION DATA:

- (1) diameter (inches) 4
- (2) total depth (feet) 153
- (3) static water level (feet) 55 below above, top of ground.
- (4) casing PVC, 153,
(material) (depth)
(size) If telescope see back.
- (5) screen 10, 143
(length) (depth to top)
12, PVC
(size) (material)
- (6) pump 1, 22
(HP) (yield gpm)
(type power)
- (7) electric log no
(yes or no)
(organization running log)
- (8) how well bottom plugged Shut

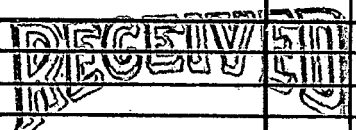


JUN 7 1991

Dept. of Environmental Quality
Bureau of Land & Water Resources

DRILLERS REMARKS:

If well telescopes please sketch and show depths.

GROUND LEVEL

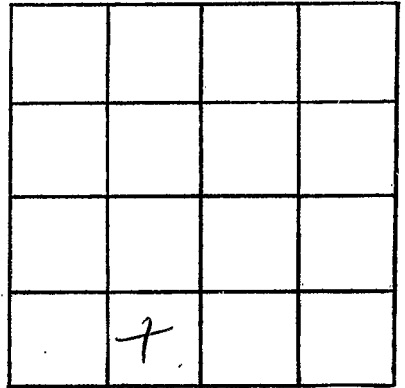

SECTION _____

Please indicate well location X.

ADDITIONAL INFORMATION

If more than one screen,
show locations of each on sketch.