

MISSISSIPPI DEPARTMENT OF ENVIRONMENTAL QUALITY
Bureau of Land and Water Resources

P. O. Box 10631
Jackson, MS 39289-0631
WATER WELL DRILLERS LOG

COUNTY WELL LOCATED PEARL RIVER	
WELL NUMBER M	CODED
DATE WELL COMPLETED 2/28/93	

PERMIT NUMBER
NAME OF DRILLING FIRM HARRINGTON DRILLING CO.

NAME & MAILING ADDRESS OF LANDOWNER Joe Didier		
1110 PRISCOVILLE		
ARABI, LA 70032		
WELL LOCATION: SEC	TOWNSHIP	RANGE
34	T.3	R.15
DISTANCE	DIRECTION	NEAREST TOWN
7.2 Miles	SOUTH	of POPLARVILLE
OTHER LANDMARK WEST OF HIGHWAY 53 SAVANNAH		
WELL PURPOSE (Home) Irrigation, Municipal, Industrial, Fish Pond, etc. HOME		

PUMP DATA		
PUMP TYPE (Circle One): Submersible, Turbine, Jet Flowing Well, Other (Describe) _____		
POWER TYPE (Circle One): Electric , Tractor, Diesel, Gasoline, Butane, Other (Describe) _____		
Pump Capacity (GPM) 12	No. of Stages 2	Setting Depth jet at 52' FT.
PUMP TEST		
Well yielded _____ GPM with a drawdown of _____ ft. after _____ hours of pumping		

WELL DATA		
Well Depth 60'	Casing Diameter (in.) 2"	Casing Length (ft.) 55'
Type of Casing PVC	Hole Depth 60'	Depth to Static Water Level
TYPE OF COMPLETION: (Circle One or More): Gravel Packed , Underreamed, Telescoped, Natural Development, Open Hole, Other		
Top of Lap Pipe or Reduction in Casing FEET IF TELESCOPED OR MORE THAN ONE SCREEN: USE BACK PAGE		

LOG DATA	
TYPE OF LOG RUN (Circle One): Electric, Gamma Ray, Density, Sonic, Neutron, Other (Describe) _____	
Name of Organization Running Log	

SCREEN DATA		
Diameter - Inches 2"	Length - Feet 5'	Slot Size - Inches .010
Screen Type PVC WRA	Depth to Bottom - Feet 60'	

GEOLOGIC DATA (Office Use Only)			
Surface Elev. 250'	Geologic Unit Miocene	Unit Thickness	Depth to Top
Subs. SWL	Date	Analysis	Aquifer Test
Driller's Remarks			


DESCRIPTION OF FORMATIONS ENCOUNTERED	FROM	TO	FORMATIONS (Continued)	FROM	TO
Red Clay	0	25'	RECEIVED JUN 16 1993		
White Clay	25'	43'			
Blue Clay	43'	50'			
gray fine sand	50'	60'			

IF MORE SPACE IS NEEDED, USE BACK

Dept. of Environmental Quality
Office of Land & Water Resources

If well telescopes please sketch and show depths.

GROUND LEVEL

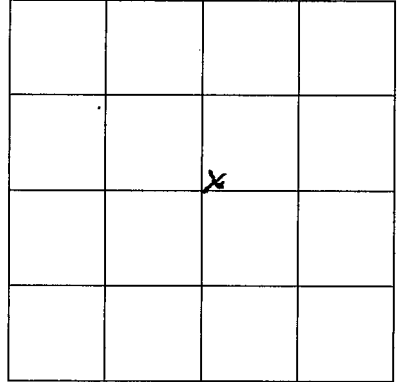

SECTION 34

Please indicate well location X.

ADDITIONAL INFORMATION

If more than one screen, show location of each on sketch.