

MISSISSIPPI DEPARTMENT OF ENVIRONMENTAL QUALITY

Office of Land and Water Resources

COUNTY WELL LOCATED
Pearl River
 WELL NUMBER
M-2069 CODED
 DATE WELL COMPLETED
10-19-99

PERMIT NUMBER
 NAME OF DRILLING FIRM
Boones Water Well

P. O. Box 10631
 Jackson, MS 39289-0631
WATER WELL DRILLERS LOG

NAME & MAILING ADDRESS OF LANDOWNER
Bobby Dunn
821 Restertown Rd
Poplarville, ms 39470
 WELL LOCATION: SEC 14 TOWNSHIP 3 N RANGE 15 E
 DISTANCE 6 Miles SE DIRECTION of Poplarville NEAREST TOWN
 OTHER LANDMARK _____
 WELL PURPOSE: Home Irrigation, Municipal, Industrial, Fish Pond, etc.

PUMP DATA

PUMP TYPE (Circle One):
 Submersible, Turbine, Jet, Flowing Well,
 Other (Describe) _____
 POWER TYPE (Circle One):
 Electric, Tractor, Diesel, Gasoline, Butane,
 Other (Describe) _____ H/P 1
 Pump Capacity (GPM) 20 No. of Stages _____ Setting Depth _____ FT.
 PUMP TEST
 Well yielded _____ GPM with
 a drawdown of _____ ft.
 after _____ hours of pumping

WELL DATA

Well Depth <u>300</u>	Casing Diameter (In.) <u>4 in</u>	Casing Length (Ft.) <u>350</u>
Type of Casing <u>sch 40</u>	Hole Depth <u>300</u>	Depth to Static Water Level <u>175</u>

TYPE OF COMPLETION: (Circle One or More):
 Gravel Packed, Underreamed, Telescoped,
 Natural Development, Open Hole, Other
 (Describe) _____

LOG DATA

TYPE OF LOG RUN (Circle One):
 No Log Run,
 Electric, Gamma Ray, Density, Sonic, Neutron,
 Other (Describe) _____
 Name of Organization Running Log _____

WELL GROUTED TO A DEPTH OF 10 FEET
 Type Grout (circle one) Cement, Bentonite, or Mix

GEOLOGIC DATA (Office Use Only)

Surface Elev.	Geologic Unit	Unit Thickness	Depth to Top
Subs. SWL	Date	Analysis	Aquifer Test

SCREEN DATA

Diameter - Inches <u>4 in</u>	Length - Feet <u>20</u>	Slot Size - Inches <u>#8</u>
Screen Type <u>sch 40</u>	Depth to Bottom - Feet	

Driller's Remarks _____

 Top of Lap Pipe or Reduction in Casing

 IF TELESKOPIED OR MORE THAN
 ONE SCREEN, USE BACK PAGE

DESCRIPTION OF FORMATIONS ENCOUNTERED	FROM	TO	FORMATIONS (Continued)	
			FROM	TO
Clay	0	280		
Sand	280	320		


JUL 27 2000

Dept. of Environmental Quality
 Office of Land & Water Resources

IF MORE SPACE IS NEEDED, USE BACK

If well telescopes please sketch and show depths.

GROUND LEVEL

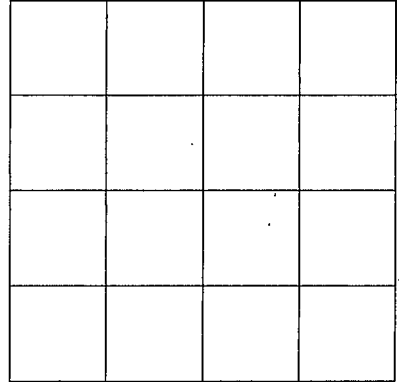

SECTION _____

Please indicate well location X.

ADDITIONAL INFORMATION

If more than one screen,
show location of each on sketch.