

Pearl R.  
 N-1  
 1-5-61

WATER WELL DRILLERS LOG

**CODED**

Date Jan 5, 1961, Driller: Leo Fisher County Pearl River  
 (Name)

(1) Owner of Land: Other Page  
 (Name)  
Paperville Miss  
 (Address)

(2) Location: 1/4, 1/4, Sec. 14 T3R 4  
10 miles East of Paperville  
 (distance) (direction) (Nearest Town)

(3) Topography: ✓  
 (Hilly) (Flat) (Level)

(4) Purpose of Well: None use  
 (Domestic Irrigation  
 Municipal, Industrial, Other)

Description & Color of Materials Sand, Clay, Red Clay, Shell, etc.	Thick- ness Feet	Depth Feet
<u>clay</u>	<u>10</u>	<u>6-10</u>
<u>sand</u>	<u>30</u>	<u>10-40</u>
<u>clay</u>	<u>45</u>	<u>40-85</u>
<u>sand</u>	<u>7</u>	<u>80-90</u>
<u>clay</u>	<u>43</u>	<u>92-135</u>
<u>sand</u>	<u>19</u>	<u>135-154</u>

Information upon completion of well:

(1) Diameter 2 inches.

(2) Total Depth 154 feet.

(3) Water Level Flowing feet below top of ground.

(4) Cased to 144 Size 2"


(5) Screen: Size 60 # Length 10ft

(6) Were any formations sealed against pollution?  
✓ yes, no.

**CODED**

If YES depth of formation \_\_\_\_\_  
 Why \_\_\_\_\_

Drillers Remarks: \_\_\_\_\_  
 \_\_\_\_\_  
 \_\_\_\_\_

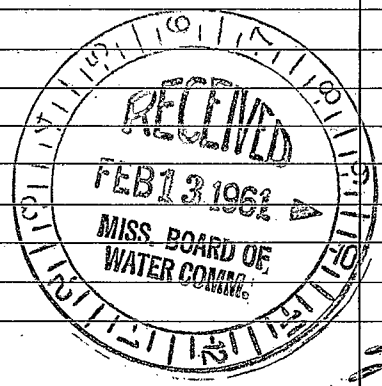

25 Well No.

(Use Back Side)

