

PEARL RIVER
N 4
12-5-70

MISSISSIPPI
 BOARD OF WATER COMMISSIONERS
 416 North State Street
 Jackson, Mississippi 39201

WATER WELL DRILLERS LOG

Dec - 5 19 70 South water wells Pearl River
 date well completed firm name county well located

LANDOWNER: Offred Head
Rt. 2
Madisonville Miss
 (mailing address)

description of formations encountered		from	to
Clay		70'	12'
Fine Sand		12'	17'
Clay		17'	50'
Coarse Sand		50'	78'

WELL LOCATION:
 sec. 32 T. 3 N. R. 14 E.
12 miles S-E of Madisonville
 (distance) (direction) (nearest town)

WELL PURPOSE: Home
 (home, irrigation, municipal, industrial)

WELL COMPLETION DATA:
 (1) diameter (inches) 2"
 (2) total depth (feet) 78"
 (3) static water level (feet) 30 below top of ground.
 (4) casing plastic, 73"
 (material) (depth)
2" if telescope see back.
 (size)
 (5) screen 5' 73"
 (length) (depth to top)
2" plastic
 (size) (material)
 (6) pump 1 5
 (HP) (yield gpm)
220
 (type power)
 (7) electric log
 (yes or no)

(organization running log)
 (8) how well bottom plugged Small plug
Back with valves


JAN 6 - 1971

MISS. BD. OF
 WATER CONTROL

DRILLERS REMARKS:

If well telescopes please sketch and show depths.

GROUND LEVEL

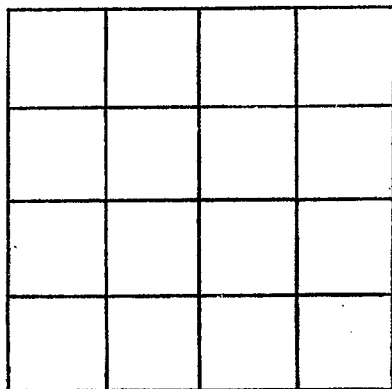

SECTION _____

Please indicate well location X.

ADDITIONAL INFORMATION

If more than one screen,
show locations of each on sketch.