

PEARL RIVER
N 5
2-24-72

MISSISSIPPI
BOARD OF WATER COMMISSIONERS
416 North State Street
Jackson, Mississippi 39201

CODED

WATER WELL DRILLERS LOG

2-29 1972 Parwell Anderson Pearl River
date well completed firm name county well located

LANDOWNER: William W. MATTIX, Sr.
347 20th Street
New Orleans LA 70124
(mailing address)

| description of formations encountered | from | to |
|---------------------------------------|------|-----|
| Top Soil | 0 | 3 |
| Red Clay | 3 | 23 |
| Fine sand | 23 | 28 |
| Blue Clay | 28 | 140 |
| Fine sand | 140 | 157 |
| Coarse Sand | 157 | 168 |

WELL LOCATION:
sec. 15 T-3 R 14 S W
8 miles S-E of Pearlville
(distance) (direction) (nearest town)

WELL PURPOSE: Camp
(home, irrigation, municipal, industrial)

- WELL COMPLETION DATA:
- (1) diameter (inches) 2
 - (2) total depth (feet) 168
 - (3) static water level (feet) 11 above top of ground.
 - (4) casing Plastic, 163, (material) (depth)
 - (size) if telescope see back.
 - (5) screen 5', 163 (length) (depth to top)
 - 2", Plastic (size) (material)
 - (6) pump No Pump 12 (HP) (yield gpm)
 - (type power)
 - (7) electric log (yes or no)
 - (organization running log)
 - (8) how well bottom plugged Backwash valve


CODED

DRILLERS REMARKS:

DEC 11 1972

If well telescopes please
sketch and show depths.

GROUND LEVEL

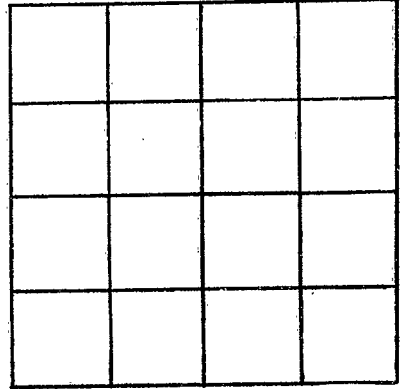

SECTION _____

Please indicate well location X.

ADDITIONAL INFORMATION

If more than one screen,
show locations of each on sketch.