

CODED

P.R.
N7
10-25-73

MISSISSIPPI
BOARD OF WATER COMMISSIONERS
416 North State Street
Jackson, Mississippi 39201

WATER WELL DRILLERS LOG

Oct 25 1973 Horace A Poole Pearl River
date well completed firm name county well located

LANDOWNER: W.J. Crosby
Rt # 2 Poplarville
Miss (mailing address)

description of formations encountered	from	to
Soft Free Clay	0	15
Sand	15	36
Sandy Clay	36	80
Silt Sand	80	90
Clay	90	150
Sand & Gravel	150	176

WELL LOCATION:
sec. 6 T. 3 R. 14
12 miles NE of Poplarville
(distance) (direction) (nearest town)

WELL PURPOSE: HOME
(home, irrigation, municipal, industrial)

WELL COMPLETION DATA:

(1) diameter (inches) 4 1/2

(2) total depth (feet) 176

(3) static water level (feet) 50 below top of ground.

(4) casing PVC, 171 (material) (depth)
2" (size) if telescope see back.

(5) screen 5, 171 (length) (depth to top)
2" o.d., PVC (size) (material)

(6) pump 1 (HP) 6 (yield gpm)
Elec (type power)

(7) electric log no (yes or no)

(organization running log)

(8) how well bottom plugged
B.P.C. K Wash Valve


CODED

DRILLERS REMARKS:

OCT 31 1973

If well telescopes please sketch and show depths.

GROUND LEVEL

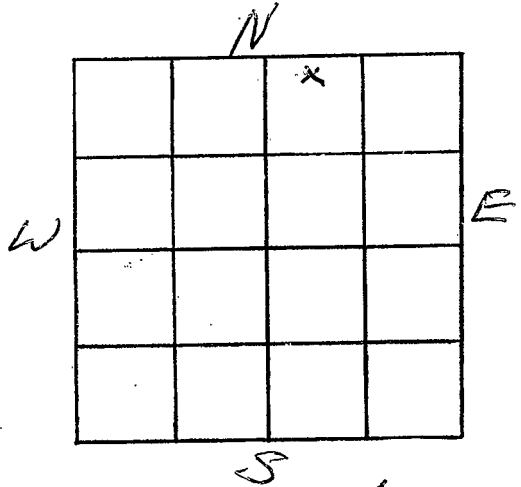

SECTION

Please indicate well location X.

ADDITIONAL INFORMATION

If more than one screen, show locations of each on sketch.