

P.R.
 N19
 9/25/74

MISSISSIPPI
 BOARD OF WATER COMMISSIONERS
 416 North State Street
 Jackson, Mississippi 39201

CODED

WATER WELL DRILLERS LOG

9-25
 date well completed

1974 Donnell Anderson
 firm name

Perel River
 county well located

LANDOWNER:
Don Verdoso
 (mailing address)

WELL LOCATION:
 sec. 23 T-3 R-14
12 miles SE of Poplarville
 (distance) (direction) (nearest town)

WELL PURPOSE: HOME
 (home, irrigation, municipal, industrial)

WELL COMPLETION DATA:

(1) diameter (inches) 2"

(2) total depth (feet) 105'

(3) static water level (feet) 67' below
 top of ground.

(4) casing Plastic, 100'
 (material) (depth)

 if telescope see back.
 (size)

(5) screen 5', 100'
 (length) (depth to top)

2", Plastic
 (size) (material)

(6) pump 1 8
 (HP) (yield gpm)

Elect
 (type power)


(7) electric log no
 (yes or no)

 (organization running log)

(8) how well bottom plugged
Back wash tube

description of formations encountered	from	to
<u>Top Soil</u>	<u>0</u>	<u>4</u>
<u>Coarse Sand</u>	<u>4</u>	<u>18</u>
<u>white clay</u>	<u>18</u>	<u>32</u>
<u>Blue clay</u>	<u>32</u>	<u>53</u>
<u>fine sand</u>	<u>53</u>	<u>89</u>
<u>Coarse Sand</u>	<u>89</u>	<u>105</u>

CODED

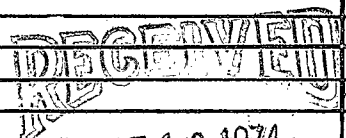


DRILLERS REMARKS:

OCT 10 1974

If well telescopes please sketch and show depths.

GROUND LEVEL

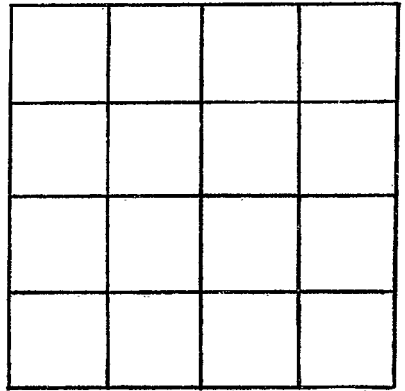

SECTION _____

Please indicate well location X.

ADDITIONAL INFORMATION

If more than one screen, show locations of each on sketch.