

PEARL RIVER
N12
3-19-74

MISSISSIPPI
 BOARD OF WATER COMMISSIONERS **CODED**
 416 North State Street
 Jackson, Mississippi 39201

WATER WELL DRILLERS LOG

3-19 19**74** **Markhurst Water Well Inc.** **Pearl River**
 date well completed firm name county well located

LANDOWNER: **Camp-Air-40-40**
Rt. 2 Poplarville
Miss
 (mailing address)

description of formations encountered	from	to
Clay	0	80
Fine Sand	80	150
Clay	150	400
Fine Sand	400	525
Coarse Sand	525	567

WELL LOCATION:
 sec **35** T **3** R **14**
14 miles **SE** of **Poplarville**
 (distance) (direction) (nearest town)

WELL PURPOSE: **Industrial**
 (home, irrigation, municipal, industrial)

WELL COMPLETION DATA:

(1) diameter (inches) **4"**

(2) total depth (feet) **567'**

(3) static water level (feet) **1** below above top of ground.

(4) casing **Steel** **567'**
 (material) (depth)

2 1/2" if telescope see back.
 (size)

(5) screen **20'** **547'**
 (length) (depth to top)

2" **Stainless Steel**
 (size) (material)

(6) pump **2** **96**
 (HP) (yield gpm)


Electric
 (type power)

(7) electric log **No**
 (yes or no)

(organization running log)

(8) how well bottom plugged **Backwash**
vacuum

CODED

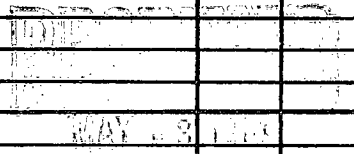

DRILLERS REMARKS:


If well telescopes please sketch and show depths.

GROUND LEVEL

210
4"

337
2 1/2"

20' 2" screen

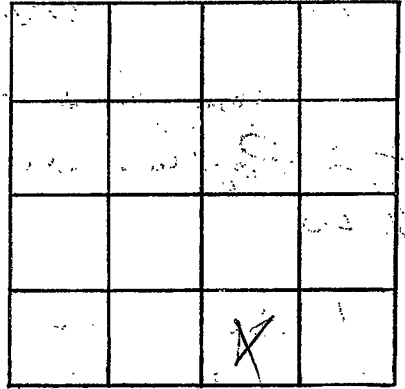

SECTION 35

Please indicate well location X.

ADDITIONAL INFORMATION

If more than one screen, show locations of each on sketch.