

N 13
 5/19/75
 Pearl River

MISSISSIPPI
 BOARD OF WATER COMMISSIONERS
 416 North State Street
 Jackson, Mississippi 39201

CODED

WATER WELL DRILLERS LOG

5-19 1975 Ponton Well Serv Pearl River
 date well completed firm name county well located

LANDOWNER: Grady Burge
 Pt. 2
 Poplarville Miss
 (mailing address)

description of formations encountered	from	to
Surface Clay	0	12
Sand	12	17
Blue Clay	17	80
Sand	80	105
Blue Clay	105	290
Sand	290	342

WELL LOCATION:
 sec. 6 T. 3 N. R. 14 E.
 S W
 6 miles East of Poplarville
 (distance) (direction) (nearest town)

WELL PURPOSE: Home
 (home, irrigation, municipal, industrial)


- WELL COMPLETION DATA:
- (1) diameter (inches) 2
 - (2) total depth (feet) 342
 - (3) static water level (feet) 29 below top of ground.
 - (4) casing Galv. 332 (material) (depth)
 - 2 (size) if telescope see back.
 - (5) screen 10' 332 (length) (depth to top)
 - 2 3. steel (size) (material)
 - (6) pump 1 12 (HP) (yield gpm)
 - Elec (type power)
 - (7) electric log No (yes or no)
 - (organization running log)
 - (8) how well bottom plugged B.W. Valve

DRILLERS REMARKS:

RECEIVED
 MAY 9 1975
 MISS. Bd. OF WATER COMMISSIONERS

If well telescopes please sketch and show depths.

GROUND LEVEL

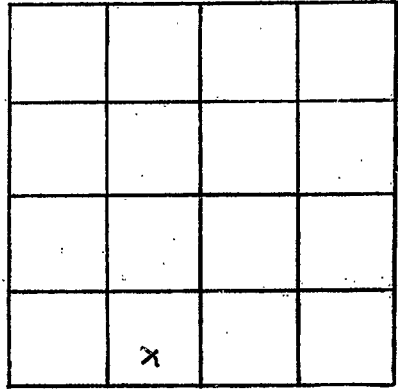

SECTION 6

Please indicate well location X.

ADDITIONAL INFORMATION

If more than one screen, show locations of each on sketch.