

Pearl River  
N 14  
6-5-75

MISSISSIPPI  
BOARD OF WATER COMMISSIONERS  
416 North State Street  
Jackson, Mississippi 39201

CODED

WATER WELL DRILLERS LOG

6-5-75 date well completed  
Bud Penton & Son Pearl River firm name  
county well located


LANDOWNER: Penton Paris Poplarville, Miss (mailing address)	description of formations encountered white shale grey sand	from	to
		0	230

WELL LOCATION:  
sec 18 T 3 N R 14 E 13S  
8 miles <sup>(S)</sup> N.E. of <sup>(N)</sup> Poplarville  
(distance) (direction) (nearest town)

WELL PURPOSE: None  
(home, irrigation, municipal, industrial)


- WELL COMPLETION DATA:
- (1) diameter (inches) 2 in
  - (2) total depth (feet) 230
  - (3) static water level (feet) 143 below above top of ground.
  - (4) casing PVC 220  
(material) (depth)
  - (size) If telescope see back.
  - (5) screen 2x10 220  
(length) (depth to top)
  - 12 PVC  
(size) (material)
  - (6) pump (HP) (yield gpm)  
electric  
(type power)
  - (7) electric log (yes or no)
  - (organization running log)
  - (8) how well bottom plugged  
hard shale

DRILLERS REMARKS:

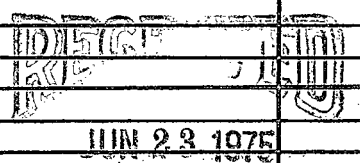

If well telescopes please sketch and show depths.

GROUND LEVEL

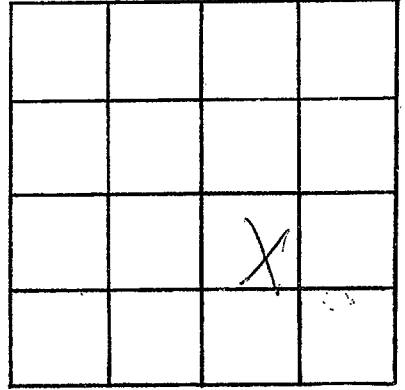

SECTION \_\_\_\_\_

Please indicate well location X.

ADDITIONAL INFORMATION

If more than one screen,  
show locations of each on sketch.