

N 15
 Pearl River
 6-9-75


MISSISSIPPI
 BOARD OF WATER COMMISSIONERS
 416 North State Street
 Jackson, Mississippi 39201

CODED

WATER WELL DRILLERS LOG

6-9 1975 date well completed
 Ernest Anderson firm name
 Pearl River county well located


LANDOWNER:	description of formations encountered	from	to
D. E. McDonald	Top Soil	0	4
(mailing address)	Pink Clay	4	32
WELL LOCATION:	Coarse Sand	32	45
sec. 9 T 3 S R 14 E 13 S W	White Clay	45	80
(distance) miles (direction) of (nearest town)	Blue Clay	8	100
WELL PURPOSE: HOME	Coarse Sand	100	119
(home, irrigation, municipal, industrial)			
WELL COMPLETION DATA:			
(1) diameter (inches) 2			
(2) total depth (feet) 119'			
(3) static water level (feet) 68' below top of ground			
(4) casing Plastic, 114' (material) (depth)			
(size) if telescope see back.			
(5) screen 5' 114' (length) (depth to top)			
2" Plastic (size) (material)			
(6) pump 1 HP 7 (yield gpm)			
Electric (type power)			
(7) electric log no (yes or no)			
(organization running log)			
(8) has well bottom plugged			
DRILLERS REMARKS:			

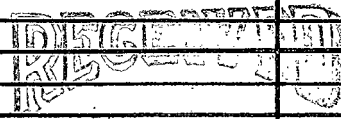

1975 - 2 1975

If well telescopes please
sketch and show depths.

GROUND LEVEL

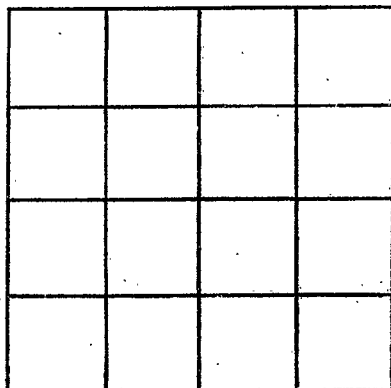

SECTION _____

Please indicate well location X.

ADDITIONAL INFORMATION

If more than one screen,
show locations of each on sketch.