

Pearl River
N 16
7-18-75

MISSISSIPPI
 BOARD OF WATER COMMISSIONERS CODED
 416 North State Street
 Jackson, Mississippi 39201

WATER WELL DRILLERS LOG

Pearl River

7-18
 date well completed

1975 Parnell Enterprises
 firm name

Pearl
 county well located

LANDOWNER:	description of formations encountered	from	to
<i>Scott Ladner</i>	<i>Top Soil</i>	<i>0</i>	<i>3</i>
(mailing address)	<i>white clay</i>	<i>3</i>	<i>14</i>
WELL LOCATION:	<i>Coarse Sand</i>	<i>14</i>	<i>25</i>
sec. <i>2</i> T. <i>3</i> N. R. <i>14</i> E. <i>135</i> <i>10</i> miles <i>E</i> of <i>Poplarville</i> (distance) (direction) (nearest town)	<i>Blue clay</i>	<i>25</i>	<i>70</i>
WELL PURPOSE: <i>HOME</i> (home, irrigation, municipal, industrial)	<i>Coarse Sand</i>	<i>70</i>	<i>80</i>
WELL COMPLETION DATA:			
(1) diameter (inches) <i>2"</i>			
(2) total depth (feet) <i>80'</i>			
(3) static water level (feet) <i>21'</i> below top of ground.			
(4) casing <i>Plastic</i> <i>75'</i> (material) (depth)			
(size) If telescope see back.			
(5) screen <i>5'</i> <i>75'</i> (length) (depth to top)			
<i>2"</i> <i>Plastic</i> (size) (material)			
(6) pump <i>1/2</i> <i>7</i> (HP) (yield gpm)			
<i>Elect</i> (type power)			
(7) electric log <i>no</i> (yes or no)			
(organization running log)			
(8) how well bottom plugged <i>Plugged</i>			
DRILLERS REMARKS:			


RECEIVED
 MISSISSIPPI
 BOARD OF WATER COMMISSIONERS

JUL 1 1975

MISSISSIPPI WATER COMMISSION

If well telescopes please sketch and show depths.

GROUND LEVEL

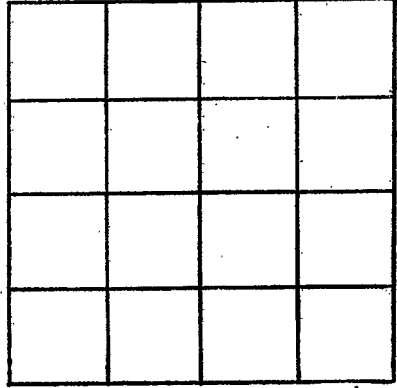

SECTION _____

Please indicate well location X.

ADDITIONAL INFORMATION

If more than one screen, show locations of each on sketch.