

Pearl River
 N 17
 8-20-75

MISSISSIPPI
 BOARD OF WATER COMMISSIONERS
 416 North State Street
 Jackson, Mississippi 39201

CODED

WATER WELL DRILLERS LOG

8-20 1975 Parnell Anderson Pearl River
 date well completed firm name county well located

LANDOWNER:	description of formations encountered	from	to
Joe Mark Smith	Top Soil	0	4
(mailing address)	Sandy Clay	4	24
WELL LOCATION:	Coarse Sand	24	70
sec. 6 T. 3 S. R. 14 E. 135			
6 miles SE of Poplarville			
(distance) (direction) (nearest town)			
WELL PURPOSE: HOME			
(home, irrigation, municipal, industrial)			
WELL COMPLETION DATA:			
(1) diameter (inches) 3"			
(2) total depth (feet) 70'			
(3) static water level (feet) 39' below top of ground.			
(4) casing Plastic, 65' (material) (depth)			
(size) if telescope see back.			
(5) screen 5' 65" (length) (depth to top)			
2" Plastic (size) (material)			
(6) pump 1/2 6 (HP) (yield gpm)			
Elect (type power)			
(7) electric log no (yes or no)			
(organization running log)			
(8) how well bottom plugged Plugged			
DRILLERS REMARKS:			

CODED


RECEIVED
 SEP 15 1975

SEP - 1 1975

MISS. BD. OF WATER COMMISSIONERS

If well telescopes please sketch and show depths.

GROUND LEVEL

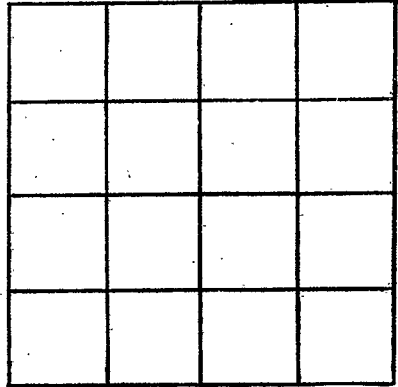

SECTION _____

Please indicate well location X.

ADDITIONAL INFORMATION

If more than one screen, show locations of each on sketch.