

Pearl River
 N 18
 9-67

MISSISSIPPI
 BOARD OF WATER COMMISSIONERS
 416 North State Street
 Jackson, Mississippi 39201

CODED

WATER WELL DRILLERS LOG

9-9 1967 Penton Well Serv Pearl River
 date well completed firm name county well located

LANDOWNER: Jim Swartz
 3220 Air Line Hwy
 Metairie La.
 (mailing address)


description of formations encountered	from	to
	Red Clay	0
White Sand	45	85
" Clay	85	228
Fine Sand	228	265
Blue Clay	265	460
Rock	460	474
Grey sand	474	526

WELL LOCATION:
 sec. 23 T. 3 S. R. 14 W.
 10 miles E. SE of Poplarville
 (distance) (direction) (nearest town)

WELL PURPOSE: Irrigation
 (home, irrigation, municipal, industrial)

CODED

WELL COMPLETION DATA:
 (1) diameter (inches) 6 1/2" Drilled
 (2) total depth (feet) 526
 (3) static water level (feet) 57 below top of ground.
 (4) casing Galv. Steel 506 (material) (depth)
 4" (size) if telescope see back.
 (5) screen 20' 506 (length) (depth to top)
 4" x 2" S. Steel (size) (material)
 (6) pump 5 100 (HP) (yield gpm)
 Elec (type power)
 (7) electric log NO (yes or no)
 (organization running log)

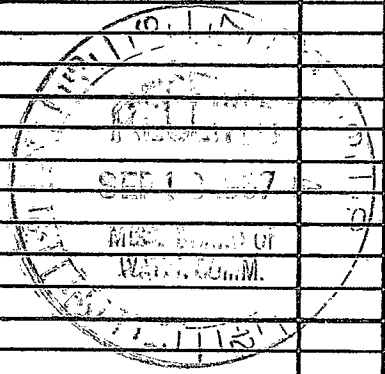

(8) how well bottom plugged BW Valve

Did not cut to bottom of sand

DRILLERS REMARKS: Screen
 4" x 5' #.010 - 4" x 5' #.012
 2" x 10' #.015

7

If well telescopes please sketch and show depths.

GROUND LEVEL

X			

SECTION 23

Please indicate well location X.

ADDITIONAL INFORMATION

If more than one screen, show locations of each on sketch.