

Pearl River
 N 19
 9-17-75

MISSISSIPPI
 BOARD OF WATER COMMISSIONERS
 416 North State Street
 Jackson, Mississippi 39201

135

WATER WELL DRILLERS LOG

9/17
 date well completed

1975 Bud Penton & Son
 firm name

Pearl River
 county well located

LANDOWNER: D P D Land
 Cop. 863 Church St.
 New Orleans
 (mailing address)

description of formations encountered	from	to
white shale	0	8
white sandstone	8	65
blue shale	65	502
gray sand	502	560

WELL LOCATION:

sec. 25 T 3 N R 14 E
 8 miles SE of Poplarville
 (distance) (direction) (nearest town)

WELL PURPOSE: home
 (home, irrigation, municipal, industrial)


WELL COMPLETION DATA:

- (1) diameter (inches) 2"
- (2) total depth (feet) 550
- (3) static water level (feet) 4 1/2 below top of ground.
- (4) casing PVC 540 (material), (depth)
 20 (size) if telescope see back.
- (5) screen 2x10, 540 (length), (depth to top)
 12 (size), PVC (material)
- (6) pump 1 (HP), 950 (yield gpm)
 yes (type power)
- (7) electric log no (yes or no)

(organization running log)

(8) how well bottom plugged
 good

DRILLERS REMARKS:

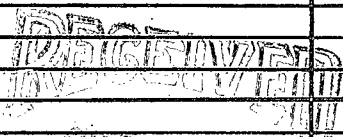


SEP 20 1975

MISS. Bd. OF WATER COMMISSIONERS

If well telescopes please
sketch and show depths.

GROUND LEVEL

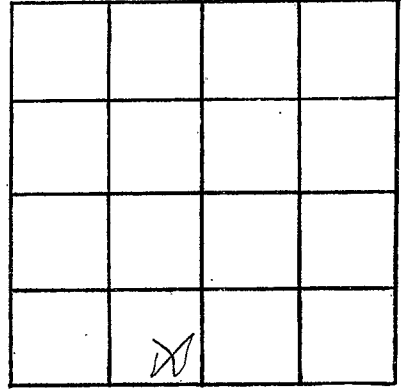

SECTION _____

Please indicate well location X.

ADDITIONAL INFORMATION

If more than one screen,
show locations of each on sketch.